

HANCOCK
G 2092
11-29-79

MISSISSIPPI
BOARD OF WATER COMMISSIONERS
416 North State Street
Jackson, Mississippi 39201

WATER WELL DRILLERS LOG

Nov. 29 1979 date well completed
Duncan Well Drilling firm name
Hancock county well located

LANDOWNER: Richard Cross

Arroyo St.

diamondhead
Bay St. Louis (mailing address)

description of formations encountered

from to

Clay	0	55
Fine Sand	55	73
Coarse Sand	73	89

WELL LOCATION:

sec 3 T 7 N R 14 E
14 miles SW of Bay St. Louis
(distance) (direction) (nearest town)

WELL PURPOSE: Heat Pump
(home, irrigation, municipal, industrial)

WELL COMPLETION DATA:

- (1) diameter (inches) 2"
- (2) total depth (feet) 89'
- (3) static water level (feet) 8' below top of ground
- (4) casing PVC, 79' (material) (depth)
- (size) If telescope see back.
- (5) screen 10' 79' (length) (depth to top)
2" PVC (size) (material)
- (6) pump 1 12 (HP) (yield gpm)
electric (type power)
- (7) electric log (yes or no)
- (organization running log)
- (8) how well bottom plugged Sand
Shark

DRILLERS REMARKS:

DEPT. OF NATURAL RESOURCES
BUREAU OF LAND & WATER RESOURCES


JAN 15 1980

RECEIVED

If well telescopes please sketch and show depths:

GROUND LEVEL

hmo2

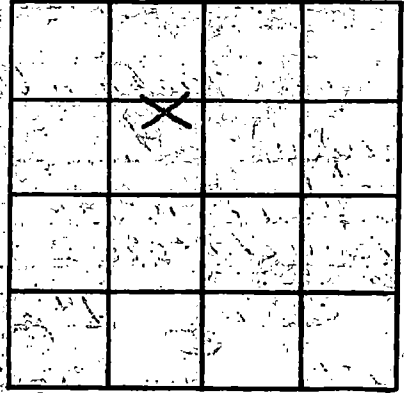

SECTION 3

Please indicate well location X:

ADDITIONAL INFORMATION

If more than one screen, show locations of each on sketch.