

MISSISSIPPI DEPARTMENT OF NATURAL RESOURCES

Bureau of Land and Water Resources

Southport Mall

P.O. Box 10631

Jackson, Mississippi 39209

WATER WELL DRILLERS LOG

HANCOCK
G 2080
6-1-81

Date well completed June 1 1981 firm name Hancock Well Drilling county well located Hancock

LANDOWNER: Mr. Haag
27136 Golf Club Dr.
Bay St. Louis
 (mailing address)

description of formations encountered	from	to
<u>clay & sand</u>	<u>0</u>	<u>15</u>
<u>white clay</u>	<u>15</u>	<u>60</u>
<u>blue clay</u>	<u>60</u>	<u>230</u>
<u>fine sand</u>	<u>230</u>	<u>260</u>
<u>coarse sand</u>	<u>260</u>	<u>273</u>

WELL LOCATION:
 sec 3 T 7 N R 14 E
5 miles N.W. of Bay St. Louis
 (distance) (direction) (nearest town)

WELL PURPOSE: Home
 (home, irrigation, municipal, industrial)

WELL COMPLETION DATA:

- (1) diameter (inches) 2"
- (2) total depth (feet) 273 ft.
- (3) static water level (feet) 75' below above top of ground.
- (4) casing PVC, 273'
 (material) (depth)
- (5) screen 10', 263'
 (length) (depth to top)
2", PVC
 (size) (material)
- (6) pump 1, 8
 (HP) (yield gpm)
electric
 (type power)
- (7) electric log
 (yes or no)

(organization running log)


(8) how well bottom plugged sand
mark

DRILLERS REMARKS:

DEPT. OF NATURAL RESOURCES
 BUREAU OF LAND & WATER RESOURCES
RECEIVED
 OCT 19 1981

If well telescopes please sketch and show depths.

GROUND LEVEL

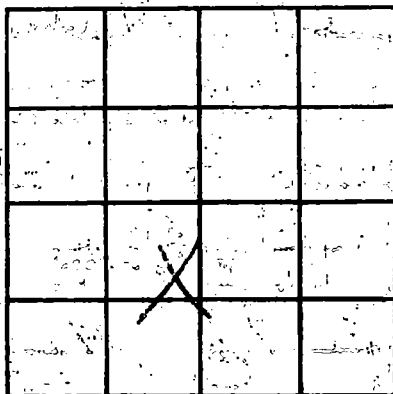

SECTION 3

Please indicate well location X.

ADDITIONAL INFORMATION

If more than one screen, show locations of each on sketch.