

MISSISSIPPI DEPARTMENT OF NATURAL RESOURCES

Bureau of Land and Water Resources

Southport Mall

P.O. Box 10631

Completed installing pump 7-15-82

Jackson, Mississippi 39209

WATER WELL DRILLERS LOG

Hancock  
G 2081

March 30 1982 Duncan Well Drilling, Hancock  
date well completed firm name county well located

LANDOWNER: Mr. Michel  
8322 Mamalu Place  
Bay St. Louis, Ms.  
(mailing address)

description of formations encountered	from	to
Clay	0	10
sand	10	40
white clay	40	118
Blue Clay	118	160
fine sand	160	180
course sand	180	210

WELL LOCATION:  
sec. 3 T. 7 N. R. 16 W.  
12 miles (distance) N of Bay St. Louis (direction) (nearest town)

WELL PURPOSE: Home  
(home, irrigation, municipal, industrial)

WELL COMPLETION DATA:  
(1) diameter (inches) 4"  
(2) total depth (feet) 210 ft.  
(3) static water level (feet) 50 below top of ground.  
(4) casing PVC, 200' (material) (depth)  
(size) if telescope see back.  
(5) screen 10' (length) 200' (depth to top)  
4" (size) PVC (material)  
(6) pump 1 (HP) 12 (yield gpm)  
electric (type power)  
(7) electric log (yes or no)  
(organization running log)  
(8) how well bottom plugged Sand Shank

DEPT. OF NATURAL RESOURCES  
BUREAU OF LAND & WATER RESOURCES


AUG 30 1982

RECEIVED

DRILLERS REMARKS:

If well telescopes please sketch and show depths.

GROUND LEVEL

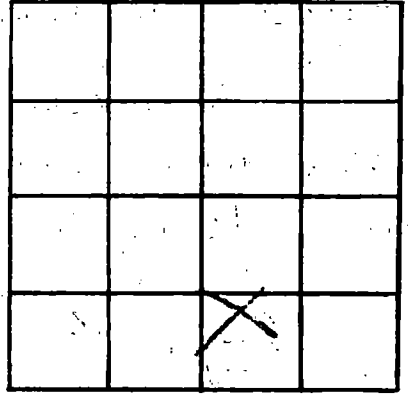

SECTION 3

Please indicate well location X.

ADDITIONAL INFORMATION

If more than one screen, show locations of each on sketch.