

HANCOCK
 BG 7080
 7-22-82

MISSISSIPPI
 BOARD OF WATER COMMISSIONERS
 416 North State Street
 Jackson, Mississippi 39201

WATER WELL DRILLERS LOG

July 22 1982 Wood Well Dr. Hancock
 date well completed firm name county well located

LANDOWNER: R.S. Calhoun
 P.O. Box 37
 Kiln, ms.
 (mailing address)

WELL LOCATION:
 sec 38 T. 2 N. R. 15 E.
 8 miles E of Kiln
 (distance) (direction) (nearest town)

WELL PURPOSE: Home
 (home, irrigation, municipal, industrial)

WELL COMPLETION DATA:

(1) diameter (inches) 2"
 (2) total depth (feet) 609
 (3) static water level (feet) 20 below top of ground.
 (4) casing PVC, 589 (material), (depth)
 (size) If telescope see back.
 (5) screen 20 (length), (depth to top)
 2" PVC (size), (material)
 (6) pump N/A (HP), (yield gpm)
 (type power)
 (7) electric log NO (yes or no)
 N/A (organization running log)
 (8) how well bottom plugged BWU

description of formations encountered	from	to
Top Soil - clay	0	12
SS	12	18
clay	18	96
SS	96	115
clay - silt	115	168
SS	168	180
clay - silt	180	295
SS	295	326
clay - silt	326	565
Coarse SS	565	609

DEPT. OF NATURAL RESOURCES
 BUREAU OF LAND & WATER RESOURCES


SEP 10 1982

RECEIVED

DRILLERS REMARKS: G.P.M.-56
 8 PST

If well telescopes please sketch and show depths.

GROUND LEVEL

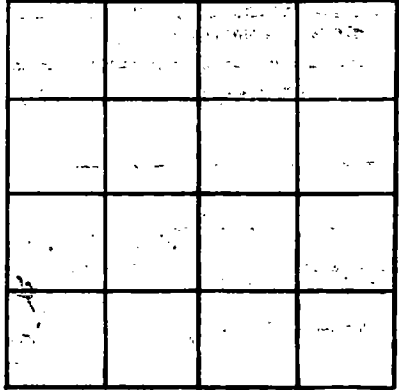

SECTION 38

Please indicate well location X.

ADDITIONAL INFORMATION

If more than one screen, show locations of each on sketch.

Handwritten notes: 58-55-1, 2, 5