

**MISSISSIPPI DEPARTMENT OF NATURAL RESOURCES**  
**Bureau of Land and Water Resources**  
 Southport Mall  
 P.O. Box 10631  
 Jackson, Mississippi 39209  
**WATER WELL DRILLERS LOG**

Hancock  
G 7084

Sept. 23 1982 Duncan Well Drilling Hancock  
 date well completed firm name county well located

LANDOWNER: Pete Haddad  
652 Kpula Diamondhead  
Bay St. Louis Ms.  
 (mailing address)

description of formations encountered	from	to
<u>Mud and Sand</u>	<u>0</u>	<u>60</u>
<u>Clay sand mixed</u>	<u>60</u>	<u>85</u>
<u>Blue Clay</u>	<u>85</u>	<u>118</u>
<u>White Blue Clay</u>	<u>118</u>	<u>225</u>
<u>Green Sand</u>	<u>225</u>	<u>260</u>
<u>O'Connor Sand</u>	<u>260</u>	<u>290</u>

WELL LOCATION:  
 sec. 3 T. 7 N. R. 18 E.  
12 miles N of Bay St. Louis  
 (distance) (direction) (nearest town)

WELL PURPOSE: Home  
 (home, irrigation, municipal, industrial)

WELL COMPLETION DATA:

- (1) diameter (inches) 4" x 2" 140# x 2"
- (2) total depth (feet) 290'
- (3) static water level (feet) 25' below above top of ground.
- (4) casing PVC 280  
 (material) (depth)
- (size) if telescope see back.
- (5) screen 10' 280  
 (length) (depth to top)
- 2" PVC  
 (size) (material)
- (6) pump 1 20  
 (HP) (yield gpm)
- electric  
 (type power)
- (7) electric log         
 (yes or no)

        
 (organization running log)

(8) how well bottom plugged land  
shark

DRILLERS REMARKS:       


DEPT. OF NATURAL RESOURCES  
 BUREAU OF LAND & WATER RESOURCES

JAN 21 1983

**RECEIVED**

If well telescopes please sketch and show depths.

GROUND LEVEL

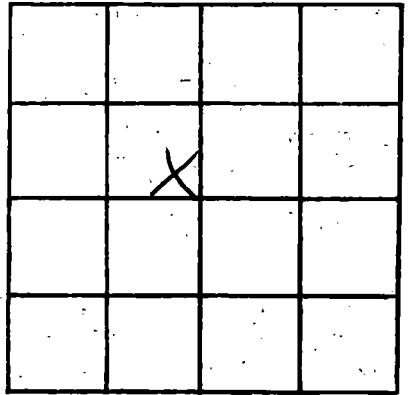

SECTION 3

Please indicate well location X:

ADDITIONAL INFORMATION

If more than one screen,  
show locations of each on sketch.