

Hancock
G2085

MISSISSIPPI
BOARD OF WATER COMMISSIONERS
416 North State Street
Jackson, Mississippi 39201

WATER WELL DRILLERS LOG

10-30 1982 Penton Well Serv Hancock
date well completed firm name county well located

LANDOWNER: <u>Carl McIntire</u>	description of formations encountered	from	to
<u>Kiln - MS.</u> (mailing address)			
	<u>Silt</u>	<u>60</u>	<u>120</u>
	<u>Blue Clay</u>	<u>120</u>	<u>160</u>
	<u>Sand</u>	<u>160</u>	<u>210</u>

WELL LOCATION:
sec. 23 T 7 R 14 E
S W
1 miles East of Fenton
(distance) (direction) (nearest town)

WELL PURPOSE: Home
(home, irrigation, municipal, industrial)

- WELL COMPLETION DATA:
- (1) diameter (inches) 2
 - (2) total depth (feet) 210
 - (3) static water level (feet) Flow below above top of ground.
 - (4) casing PVC, 200
(material) (depth)
2 If telescope see back.
(size)
 - (5) screen 10, 200
(length) (depth to top)
2, PVC
(size) (material)
 - (6) pump
(HP) (yield gpm)

(type power)
 - (7) electric log No
(yes or no)
(organization running log)
 - (8) how well bottom plugged BW Valve

DRILLERS REMARKS:


DEPT. OF NATURAL RESOURCES
BUREAU OF LAND & WATER RESOURCES

NOV - 8 1982

RECEIVED

If well telescopes please sketch and show depths.

GROUND LEVEL

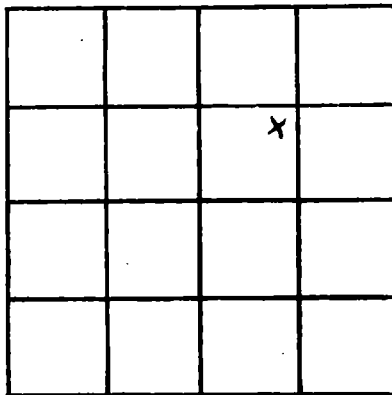

SECTION 23

Please indicate well location X.

ADDITIONAL INFORMATION

If more than one screen, show locations of each on sketch.