

MISSISSIPPI DEPARTMENT OF NATURAL RESOURCES

Bureau of Land and Water Resources

Southport Mall

P.O. Box 10631

Jackson, Mississippi 39209

WATER WELL DRILLERS LOG

11-9-1982 date well completed      Ward Well Ply. firm name      Hancock county well located

LANDOWNER	description of formations encountered	from	to
Mike Huston	Top Soil - clay	0	20
Fire tower Rd.	sd	20	37
Pass Christian, miss.	clay	37	110
(mailing address)	sd	110	196
WELL LOCATION:	clay - silt	196	315
sec 2 T 7 N R 14 E	sd	315	340
23 miles N/E of Bilbo	clay - silt	340	478
(distance) (direction) (nearest town)	coal sd	478	525

WELL PURPOSE: irrigation  
(home, irrigation, municipal, industrial)

- WELL COMPLETION DATA:
- (1) diameter (Inches) 4" X 2"
  - (2) total depth (feet) 525'
  - (3) static water level (feet) 2' below top of ground
  - (4) casing (material) Steel (depth) 505'
  - (size) If telescope see back.
  - (5) screen (length) 20' (depth to top) -
  - (size) 2" (material) Stainless
  - (6) pump (HP) 1 (yield gpm) 30
  - (type power) Elec.
  - (7) electric log (yes or no) NO
  - (organization running log) N/A
  - (8) how well bottom plugged BWV

DEPT. OF NATURAL RESOURCES  
BUREAU OF LAND & WATER RESOURCES


DEC 20 1982

RECEIVED

DRILLERS REMARKS: N/A

If well telescopes please sketch and show depths.

GROUND LEVEL

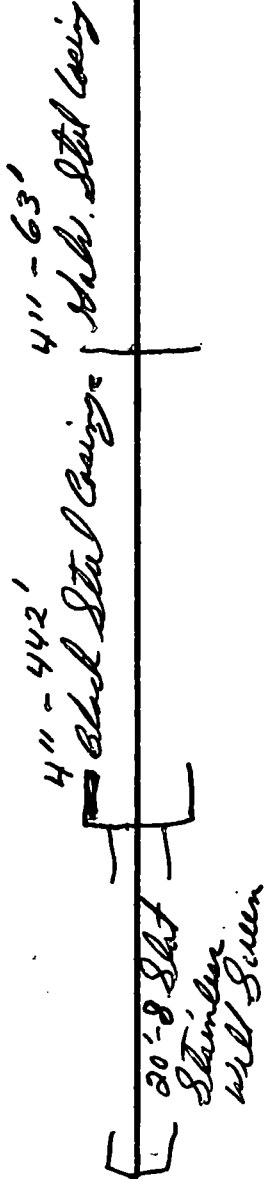

	X		

SECTION 2

Please indicate well location X.

ADDITIONAL INFORMATION

If more than one screen, show locations of each on sketch.