

MISSISSIPPI DEPARTMENT OF NATURAL RESOURCES

Bureau of Land and Water Resources

Southport Mall

P.O. Box 10631

Jackson, Mississippi 39209

WATER WELL DRILLERS LOG

Hancock
G-2089

1-25- 1983
date well completed

83 Ward Well Dr.
firm name

Hancock
county well located

LANDOWNER: Lloyd ROQUES
Rt. 1, Box 33
Pass Christian, Miss.
(mailing address)

description of formations encountered	from	to
<u>clay</u>	<u>0</u>	<u>25</u>
<u>sd - clay</u>	<u>25</u>	<u>68</u>
<u>clay</u>	<u>68</u>	<u>110</u>
<u>fine sd</u>	<u>110</u>	<u>126</u>
<u>clay - silt</u>	<u>126</u>	<u>270</u>
<u>coarse sd</u>	<u>270</u>	<u>294</u>

WELL LOCATION:
sec. 10 T. 7 N. R. 14 E.
123 miles S N/E of KILN
(distance) (direction) (nearest town)

WELL PURPOSE: None
(home, irrigation, municipal, industrial)

- WELL COMPLETION DATA:
- (1) diameter (inches) 2"
 - (2) total depth (feet) 294
 - (3) static water level (feet) 60 ^{below} _{above} top of ground.
 - (4) casing PVC, 284,
(material) (depth)
- If telescope see back.
(size)
 - (5) screen 10', -
(length) (depth to top)
2", PVC
(size) (material)
 - (6) pump 1 15
(HP) (yield gpm)
Elec.
(type power)
 - (7) electric log NO
(yes or no)
N/A
(organization running log)
 - (8) how well bottom plugged BWU

DEPT. OF NATURAL RESOURCES
BUREAU OF LAND & WATER RESOURCES


MAR - 4 1983

RECEIVED

DRILLERS REMARKS: N/A

If well telescopes please sketch and show depths.

GROUND LEVEL

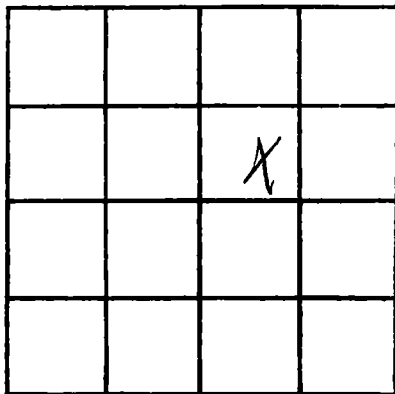

SECTION 10

Please indicate well location X.

ADDITIONAL INFORMATION

If more than one screen,
show locations of each on sketch.