

MISSISSIPPI DEPARTMENT OF NATURAL RESOURCES

Bureau of Land and Water Resources

Southport Mall

P.O. Box 10631

Jackson, Mississippi 39209

WATER WELL DRILLERS LOG

Hancock
G 2091

May 18 1983 Duncan Well Drilling Hancock
date well completed firm name county well located

LANDOWNER: August Waker
Rt. 1 Box 472
Pass Christian, Ms.
(mailing address)

description of formations encountered	from	to
<u>Clay</u>	<u>0</u>	<u>18</u>
<u>Sand</u>	<u>18</u>	<u>120</u>
<u>Blue Clay</u>	<u>120</u>	<u>290</u>
<u>Clay & Sand</u>	<u>290</u>	<u>380</u>
<u>fine sand</u>	<u>380</u>	<u>410</u>
<u>Course Sand</u>	<u>410</u>	<u>430</u>

WELL LOCATION:
sec. 19 T. 7 N. R. 14 E. W
3 miles N of Belz
(distance) (direction) (nearest town)

WELL PURPOSE: Home
(home, irrigation, municipal, industrial)

- WELL COMPLETION DATA:
- (1) diameter (inches) 2"
 - (2) total depth (feet) 430 ft.
 - (3) static water level (feet) 10' below above top of ground.
 - (4) casing PVC 420
(material) (depth)
— If telescope see back.
(size)
 - (5) screen 10' 420
(length) (depth to top)
2" PVC
(size) (material)
 - (6) pump 1 8
(HP) (yield gpm)
electric
(type power)
 - (7) electric log —
(yes or no)
—
(organization running log)
 - (8) how well bottom plugged sand
shark

DRILLERS REMARKS:


DEPT. OF NATURAL RESOURCES
BUREAU OF LAND & WATER RESOURCES

AUG 15 1983

RECEIVED

If well telescopes please sketch and show depths.

GROUND LEVEL

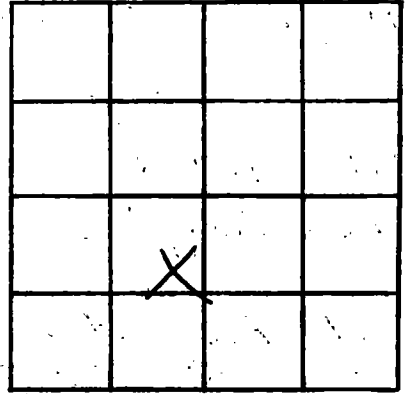

SECTION 19

Please indicate well location X.

ADDITIONAL INFORMATION

If more than one screen,
show locations of each on sketch.