

MISSISSIPPI DEPARTMENT OF NATURAL RESOURCES
Bureau of Land and Water Resources
 Southport Mall
 P.O. Box 10631
 Jackson, Mississippi 39209
WATER WELL DRILLERS LOG

Hancock
G 2092

10-5- 19 83 Ward Well Dlg. Hancock
 date well completed firm name county well located

LANDOWNER: James Finn

River View Estate

Bay St. Louis, ms.
 (mailing address)

WELL LOCATION:

sec. 39 T. 48 N R. 14 E
8 miles N of Waveland
 (distance) (direction) (nearest town)

WELL PURPOSE: Home
 (home, irrigation, municipal, industrial)

WELL COMPLETION DATA:

- (1) diameter (inches) 2"
 (2) total depth (feet) 168
 (3) static water level (feet) 4 ^{below} top of ground
 (4) casing PVC 158
 (material) (depth)

- If telescope see back.
 (size)

- (5) screen 10' -
 (length) (depth to top)
2" PVC
 (size) (material)

- (6) pump 1/2 10
 (HP) (yield gpm)
Elec.
 (type power)

- (7) electric log NO
 (yes or no)
N/A
 (organization running log)

- (8) how well bottom plugged BWV

description of formations encountered

from	to
0	18
18	46
46	98
98	110
110	147
147	168

fill - loy

sd

clay

sd

clay - silt

sd

DEPT. OF NATURAL RESOURCES
 BUREAU OF LAND & WATER RESOURCES


OCT 2 1983

RECEIVED

DRILLERS REMARKS: N/A

If well telescopes please sketch and show depths.

GROUND LEVEL

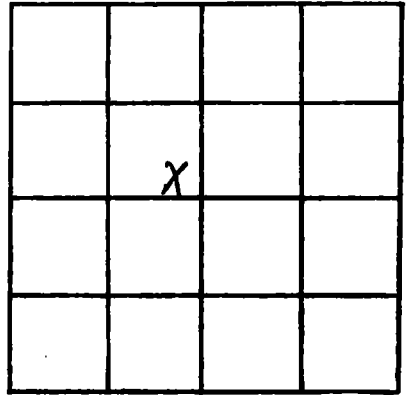

SECTION 39

Please indicate well location X.

ADDITIONAL INFORMATION

If more than one screen,
show locations of each on sketch.