

**HANCOCK**  
G 7093

MISSISSIPPI DEPARTMENT OF NATURAL RESOURCES  
Bureau of Land and Water Resources  
Southport Mall  
P.O. Box 10631  
Jackson, Mississippi 39209  
**WATER WELL DRILLERS LOG**

11-14-1983 date well completed      83 Ward Well Dlg firm name      Hancock county well located

LANDOWNER: John D. Bruce  
376 Bay View Drive  
Bay St. Louis, miss.  
(mailing address)

description of formations encountered	from	to
Clay	0	15
Sd	15	46
Clay	46	94
fine Sd	94	116
Clay - Silt	116	154
Sd	154	170

WELL LOCATION:  
sec 39 T 8 N R 14 E  
6 miles N of Waveland  
(distance) (direction) (nearest town)

WELL PURPOSE: Home  
(home, irrigation, municipal, industrial)

WELL COMPLETION DATA:

- (1) diameter (inches) 2"
- (2) total depth (feet) 170
- (3) static water level (feet) 4 below above top of ground
- (4) casing PVC 160  
(material) (depth)
- If telescope see back.  
(size)
- (5) screen 10' -  
(length) (depth to top)
- 2" PVC  
(size) (material)
- (6) pump owner  
(HP) (yield gpm)
- (type power)
- (7) electric log NO  
(yes or no)
- N/A  
(organization running log)
- (8) how well bottom plugged BWU

DRILLERS REMARKS: N/A

DEPT. OF NATURAL RESOURCES  
BUREAU OF LAND & WATER RESOURCES


JAN 13 1984

**RECEIVED**

If well telescopes please sketch and show depths.

Handwritten notes: "A4004A" and a circled "2".

GROUND LEVEL

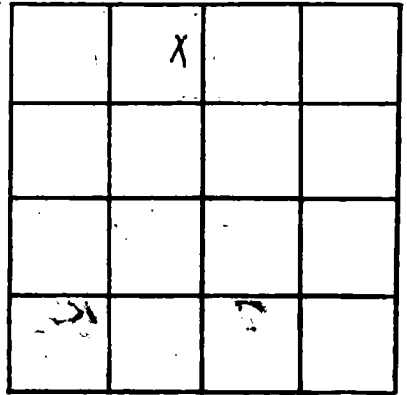

SECTION 39

Please indicate well location X.

ADDITIONAL INFORMATION

Lined area for additional information.

If more than one screen, show locations of each on sketch.