

HANCOCK
G 2094

MISSISSIPPI DEPARTMENT OF NATURAL RESOURCES
Bureau of Land and Water Resources
Southport Mall
P.O. Box 10631
Jackson, Mississippi 39209
WATER WELL DRILLERS LOG

Oct 19 1983 date well completed
Duncan Well Drilling firm name
Hancock county well located

LANDOWNER: John Fullmer
Rt 1 Box 11
Pass Christian, Ms. 39571
(mailing address)

description of formations encountered	from	to
	Sand	0
Blue Clay	60	100
fine sand	100	120
Meruse sand	120	147

WELL LOCATION:
sec. 14 T 7 N R 14 E
6 miles N.E. of Kiln
(distance) (direction) (nearest town)

WELL PURPOSE: home
(home, irrigation, municipal, industrial)

- WELL COMPLETION DATA:
- (1) diameter (inches) 2"
 - (2) total depth (feet) 147'
 - (3) static water level (feet) 25' below above top of ground.
 - (4) casing PVC, 137' (material) (depth)
— (size) if telescope see back.
 - (5) screen 10' 137' (length) (depth to top)
2" PVC (size) (material)
 - (6) pump 1 (HP) 10 (yield gpm)
electric (type power)
 - (7) electric log (yes or no)

(organization running log)
(8) how well bottom plugged Sand
Shark

DRILLERS REMARKS:


MISSISSIPPI DEPARTMENT OF NATURAL RESOURCES
BUREAU OF LAND & WATER RESOURCES

FEB - 8 1984

RECEIVED

If well telescopes please sketch and show depths.

GROUND LEVEL

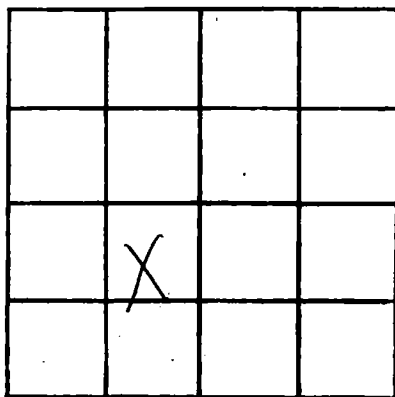

SECTION 14

Please indicate well location X.

ADDITIONAL INFORMATION

If more than one screen, show locations of each on sketch.