

HANCOCK
G 2095

MISSISSIPPI DEPARTMENT OF NATURAL RESOURCES
Bureau of Land and Water Resources
Southport Mall
P.O. Box 10631
Jackson, Mississippi 39209
WATER WELL DRILLERS LOG

5-16-1984 date well completed
Ward Well Drilling firm name
Hancock county well located

LANDOWNER: Emma Swidler
Garden St.
Bay St. Service Inc.
(mailing address)

description of formations encountered	from	to
fill - clay	0	15
sd	15	52
clay - silt	52	86
sd	86	94
clay	94	105
sd	105	115
clay - silt	115	154
sd	154	168

WELL LOCATION:
sec. 27 T. 8 N. R. 13 E. S. 14
4 miles N/W of B.S.L.
(distance) (direction) (nearest town)

WELL PURPOSE: font
(home, irrigation, municipal, industrial)

WELL COMPLETION DATA:

(1) diameter (inches) 2"

(2) total depth (feet) 168

(3) static water level (feet) 8 below above top of ground.

(4) casing PVC, 158,
(material) (depth)
2" If telescope see back.
(size)

(5) screen 10', -
(length) (depth to top)
2", PVC
(size) (material)

(6) pump - -
(HP) (yield gpm)
-
(type power)

(7) electric log NO
(yes or no)
-
(organization running log)

(8) how well bottom plugged BWU

DEPT. OF NATURAL RESOURCES
BUREAU OF LAND & WATER RESOURCES


JUL 20 1984

RECEIVED

DRILLERS REMARKS: N/A

If well telescopes please sketch and show depths.

GROUND LEVEL

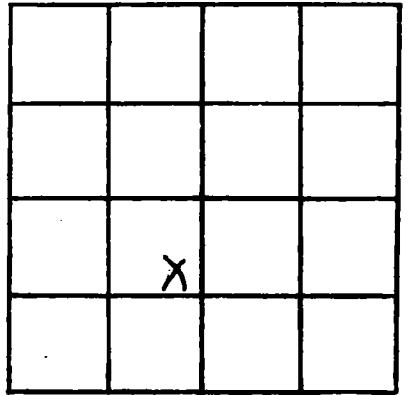

SECTION 27

Please indicate well location X.

ADDITIONAL INFORMATION

If more than one screen,
show locations of each on sketch.