

MISSISSIPPI DEPARTMENT OF NATURAL RESOURCES

Bureau of Land and Water Resources

Southport Mall

P.O. Box 10631

Jackson, Mississippi 39209

WATER WELL DRILLERS LOG

Hancock
B G 2097

Sept. 22 1984 Wood Well Dlg Hancock
date well completed firm name county well located

LANDOWNER: Hubert Debuys
Rt. 2, Box 523
Pass Christian, Miss.
(mailing address)

WELL LOCATION:
sec. 2 T 7 N R 14 E
12 miles N/E of Bilbo
(distance) (direction) (nearest town)

WELL PURPOSE: Home
(home, irrigation, municipal, industrial)

WELL COMPLETION DATA:

(1) diameter (inches) 2"

(2) total depth (feet) 295

(3) static water level (feet) 56 ^{below} above top of ground.

(4) casing PVC, 285,
(material) (depth)
- (size) if telescope see back.

(5) screen 10', -
(length) (depth to top)
2", PVC
(size) (material)

(6) pump - -
(HP) (yield gpm)
- (type power)

(7) electric log NO
(yes or no)
N/A
(organization running log)

(8) how well bottom plugged BWW


description of formations encountered	from	to
<u>Clay</u>	<u>0</u>	<u>28</u>
<u>SSdy - clay</u>	<u>28</u>	<u>65</u>
<u>clay w/ silt streaks</u>	<u>65</u>	<u>110</u>
<u>SS</u>	<u>110</u>	<u>124</u>
<u>clay - silt</u>	<u>124</u>	<u>268</u>
<u>coarse sd</u>	<u>268</u>	<u>295</u>

DRILLERS REMARKS: N/A

DEPT. OF NATURAL RESOURCES
BUREAU OF LAND & WATER RESOURCES
DEC - 2 1984
RECEIVED

If well telescopes please sketch and show depths.

GROUND LEVEL

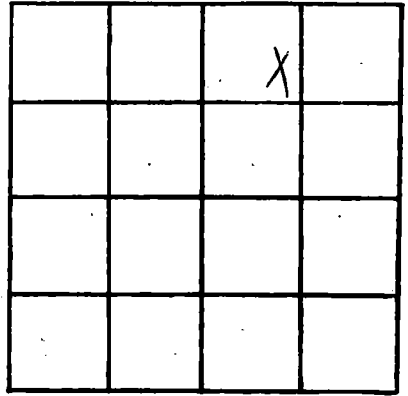

SECTION 2

Please indicate well location X.

ADDITIONAL INFORMATION

If more than one screen,
show locations of each on sketch.