

MISSISSIPPI DEPARTMENT OF NATURAL RESOURCES

Bureau of Land and Water Resources

Southport Mall

P.O. Box 10631

Jackson, Mississippi 39209

WATER WELL DRILLERS LOG

G 2098  
Hancock  
12-6-84


12/6/84 19 Thymer Well Co. Hancock  
date well completed firm name county well located

LANDOWNER	description of formations encountered	from	to
<u>Helma Gray</u> <u>Rt. 3, Box 846</u>	<u>white clay</u>	<u>0</u>	<u>20</u>
<u>Bay St. Louis, MS</u> (mailing address)	<u>sand &amp; gravel</u>	<u>20</u>	<u>40</u>
WELL LOCATION: sec. <u>12</u> T. <u>7</u> N. R. <u>14</u> E. <u>15</u> miles <u>N</u> of <u>Bay St. Louis</u> (distance) (direction) (nearest town)	<u>blue mud</u>	<u>40</u>	<u>80</u>
WELL PURPOSE: (home, irrigation, municipal, industrial)	<u>sandy clay</u>	<u>80</u>	<u>100</u>
<u>Home</u>	<u>blue clay</u>	<u>100</u>	<u>240</u>
WELL COMPLETION DATA: (1) diameter (inches) <u>2"</u> (2) total depth (feet) <u>253'</u> (3) static water level (feet) <u>40</u> below above top of ground. (4) casing <u>PVC</u> , <u>243'</u> (material) (depth) <u>2"</u> If telescope see back. (size) (5) screen <u>10'</u> , <u>243'</u> (length) (depth to top) <u>2"</u> , <u>PVC</u> (size) (material) (6) pump <u>N/A</u> (HP) (yield gpm) (type power) (7) electric log <u>NO</u> (yes or no) <u>NO</u> (organization running log) (8) how well bottom plugged <u>sand</u> <u>shark</u>	<u>coarse sand</u>	<u>240</u>	<u>253</u>
DRILLERS REMARKS:			

1-1785  
LW

If well telescopes please sketch and show depths.

GROUND LEVEL

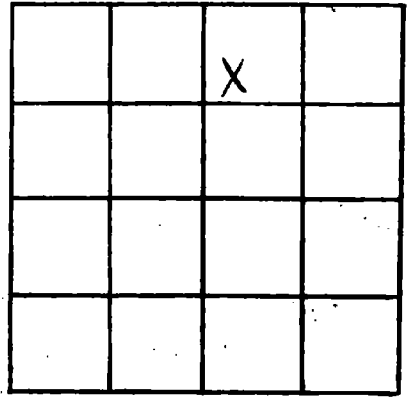

SECTION 12

Please indicate well location X.

ADDITIONAL INFORMATION

If more than one screen, show locations of each on sketch.