

MISSISSIPPI DEPARTMENT OF NATURAL RESOURCES

Bureau of Land and Water Resources

Southport Mall

P.O. Box 10631

Jackson, Mississippi 39209

WATER WELL DRILLERS LOG

HANCOCK
G 2099
12-21-84

12-21-1984 date well completed 84 Ward Well Dlg. firm name Hancock county well located

LANDOWNER:	description of formations encountered	from	to
Roy - Mail Builder Fire tower Rd.	clay	0	5
Pass Christian ms. (mailing address)	clay - silt	5	48
		48	276
		276	313

WELL LOCATION: ¹⁴
 sec. 9 T. 7 N. R. 13 E.
 10 miles N/E of Biloxi
 (distance) (direction) (nearest town)

WELL PURPOSE: Home
 (home, irrigation, municipal, industrial)

- WELL COMPLETION DATA:
- (1) diameter (inches) 2"
 - (2) total depth (feet) 313
 - (3) static water level (feet) 5 below top of ground. above
 - (4) casing PVC, 303,
 (material) (depth)
- if telescope see back.
 (size)
 - (5) screen 10', -
 (length) (depth to top)
2", PVC
 (size) (material)
 - (6) pump Power, -
 (HP) (yield gpm)
-
 (type power)
 - (7) electric log NO
 (yes or no)
N/A
 (organization running log)
 - (8) how well bottom plugged BWV


RECEIVED
 MAR 28 1985

DRILLERS REMARKS: Well was checked for bldg. Contractor.

Department of Natural Resources
 Bureau of Land & Water Resources

If well telescopes please sketch and show depths.

GROUND LEVEL

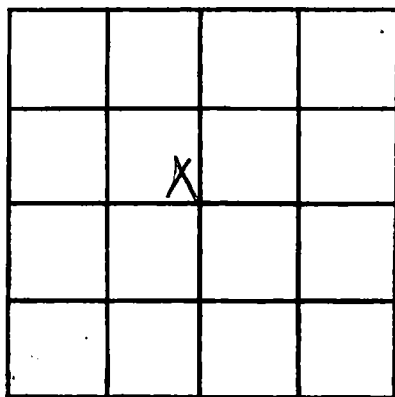

SECTION 9

Please indicate well location X.

ADDITIONAL INFORMATION

If more than one screen,
show locations of each on sketch.