

MISSISSIPPI DEPARTMENT OF NATURAL RESOURCES

Bureau of Land and Water Resources

Southport Mall

P.O. Box 10631

Jackson, Mississippi 39209

WATER WELL DRILLERS LOG

HANCOCK
G 2000

5-30

date well completed

1985 Ward Well Dlg

firm name

Hancock

county well located

LANDOWNER: Irving Jacobs
Highway 603 - Construction Site
Bay St. Louis ms.
(mailing/address)

description of formations encountered

from to

fill - clay
Sd
clay - silt
fine Sd
clay
Sd

0	14
14	45
45	96
96	112
112	147
147	168

WELL LOCATION:

sec. 28 T. 8 N. R. 13 E
6 miles N of Warland
(distance) (direction) (nearest town)

WELL PURPOSE:

(home, irrigation, municipal, industrial)

WELL COMPLETION DATA:

(1) diameter (inches) 2"
(2) total depth (feet) 168'
(3) static water level (feet) 8' below above
top of ground.

(4) casing PVC, 158'
(material) (depth)

- if telescope see back.
(size)

(5) screen 10' -
(length) (depth to top)
2" PVC
(size) (material)

(6) pump runner -
(HP) (yield gpm)
-
(type power)

(7) electric log no
(yes or no)
N/A
(organization running log)

(8) how well bottom plugged BWV


DRILLERS REMARKS: N/A

RECEIVED
AUG 20 1985

Department of Natural Resources
Bureau of Land & Water Resources

If well telescopes please sketch and show depths.

GROUND LEVEL

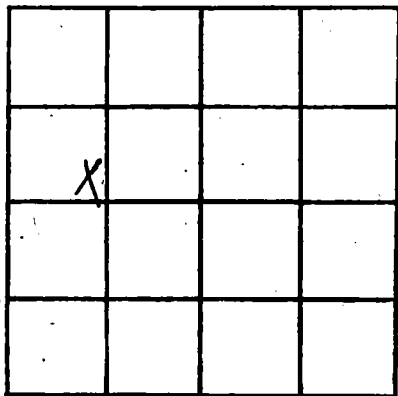

SECTION 28

Please indicate well location X.

ADDITIONAL INFORMATION

If more than one screen,
show locations of each on sketch.