

**HANCOCK**  
**HARRISON**  
 G ~~3000~~  
 2102

MISSISSIPPI DEPARTMENT OF NATURAL RESOURCES  
 Bureau of Land and Water Resources  
 Southport Mall  
 P.O. Box 10631  
 Jackson, Mississippi 39209  
**WATER WELL DRILLERS LOG**

6-10 1985 McMill Pump & Well HANCOCK  
 date well completed firm name county well located

LANDOWNER: Edwin T Clark  
Rt. 3 Box 140  
Pass Christian Ms. 39571  
 (mailing address)

WELL LOCATION:  
 sec. 8 T 7 N R 14 E  
3 miles N of Kiln  
 (distance) (direction) (nearest town)

WELL PURPOSE:  
 (home, irrigation, municipal, industrial)

WELL COMPLETION DATA: 4" = 200'  
 2" = 120'

- (1) diameter (inches) 4 1/2
- (2) total depth (feet) 320'
- (3) static water level (feet) 60' below top of ground.
- (4) casing 3 1/2" PVC, 310' (material) (depth)
- \_\_\_\_\_ If telescope see back. (size)
- (5) screen 10', 310' (length) (depth to top)
- 2", Sch. 80 PVC (size) (material)
- (6) pump 1 (HP) (yield gpm)
- Elec. (type power)
- (7) electric log \_\_\_\_\_ (yes or no)
- \_\_\_\_\_ (organization running log)
- (8) how well bottom plugged SAND  
SHARK

description of formations encountered	from	to
mud	0	40
mud / sand	40	80
mud	80	140
mud / sand	140	160
sand	160	220
sand / mud	220	240
mud	240	270
sand	270	320


**RECEIVED**  
 JUL 8 - 1985

Department of Natural Resources  
 Bureau of Land & Water Resources

DRILLERS REMARKS:

If well telescopes please sketch and show depths.

GROUND LEVEL

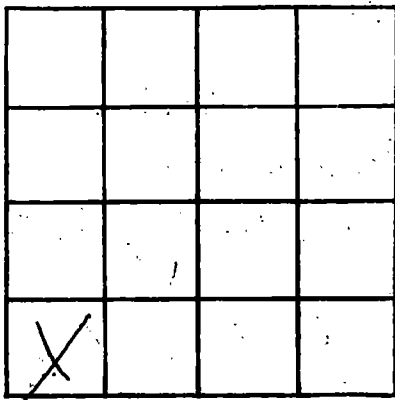

SECTION \_\_\_\_\_

Please indicate well location X.

**ADDITIONAL INFORMATION**

Lined area for additional information, consisting of 18 horizontal lines.

If more than one screen, show locations of each on sketch.