

MISSISSIPPI DEPARTMENT OF NATURAL RESOURCES

Bureau of Land and Water Resources

Southport Mall

P.O. Box 10631

Jackson, Mississippi 39209

WATER WELL DRILLERS LOG

G ~~2003~~ 2103  
 Hancock  
 8-9-85

8-9 1985 McGill Pump Well Hancock  
 date well completed firm name county well located

LANDOWNER: Harris M. Alford

description of formations encountered	from	to
<u>Mud / Sand</u>	<u>0</u>	<u>20</u>
<u>Sand / Mud</u>	<u>20</u>	<u>40</u>
<u>Mud</u>	<u>40</u>	<u>60</u>
<u>Mud / Sand</u>	<u>60</u>	<u>80</u>
<u>Sand</u>	<u>80</u>	<u>120</u>
<u>Sand / Mud</u>	<u>120</u>	<u>140</u>
<u>Mud</u>	<u>140</u>	<u>180</u>
<u>Mud / Sand</u>	<u>180</u>	<u>200</u>
<u>Sand</u>	<u>200</u>	<u>220</u>

Rt. 4 Box 22 I  
Bay St Louis, Mo. 39520  
 (mailing address)

WELL LOCATION:  
 sec 13 T 7 N R 14 E  
12 miles N of Bay St. Louis  
 (distance) (direction) (nearest town)

WELL PURPOSE:  
 (home, irrigation, municipal, industrial)

WELL COMPLETION DATA:

- (1) diameter (inches) 2"
- (2) total depth (feet) 220'
- (3) static water level (feet) 1' below above top of ground.
- (4) casing Sch 40 PVC 210'  
 (material) (depth)  
 (size) If telescope see back.
- (5) screen 10' 210'  
 (length) (depth to top)  
2" Sch 80-weld PVC  
 (size) (material)
- (6) pump N/A   
 (HP) (yield gpm)  
 (type power)
- (7) electric log (yes or no) \_\_\_\_\_  
 (organization running log) \_\_\_\_\_
- (8) how well bottom plugged Sand  
and


DRILLERS REMARKS: \_\_\_\_\_

RECEIVED  
 OCT - 8 1985

Department of Natural Resources  
 Bureau of Land & Water Resources

If well telescopes please sketch and show depths.

GROUND LEVEL

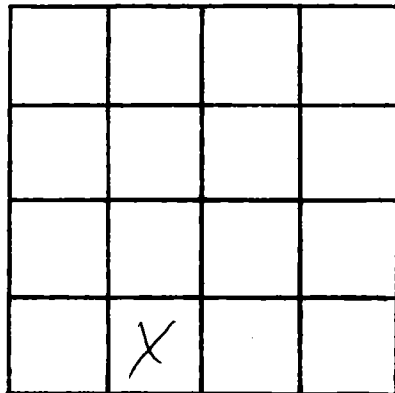

SECTION \_\_\_\_\_

Please indicate well location X.

ADDITIONAL INFORMATION

If more than one screen,  
show locations of each on sketch.