

MISSISSIPPI DEPARTMENT OF NATURAL RESOURCES

Bureau of Land and Water Resources

Southport Mall

P.O. Box 10631

Jackson, Mississippi 39209

WATER WELL DRILLERS LOG

Harwood  
G 304  
2104

3-19-86 19  
 date well completed

Pouncey Water Well  
 firm name

Harwood  
 county well located

LANDOWNER: Lance Fenton

description of formations encountered

from to

(mailing address)

WELL LOCATION:

sec. 23 T 7 N R. 14 E  
14 miles N of Fenton Church  
 (distance) (direction) (nearest town)

WELL PURPOSE: Home  
 (home, irrigation, municipal, industrial)

WELL COMPLETION DATA:

- (1) diameter (inches) 2
- (2) total depth (feet) 375
- (3) static water level (feet) 17 below above top of ground
- (4) casing PVC 360  
 (material) (depth)  
2 if telescope see back.  
 (size)
- (5) screen 15 360  
 (length) (depth to top)  
2 PVC  
 (size) (material)
- (6) pump \_\_\_\_\_ (HP) \_\_\_\_\_ (yield gpm)  
 (type power)
- (7) electric log \_\_\_\_\_ (yes or no)  
 (organization running log)
- (8) how well bottom plugged sealed

TOP	0	26
coffee clay	26	32
SD gunk	32	34
clay	34	48
sd some good	48	60
clay blue	60	121
sd to st. bottom	121	140
clay	140	316
sd.	316	336
sd to good well	336	375

RECEIVED


MAR 25 1986

DRILLERS REMARKS: owner install his pump

Department of Natural Resources  
 Bureau of Land & Water Resources

If well telescopes please sketch and show depths.

GROUND LEVEL

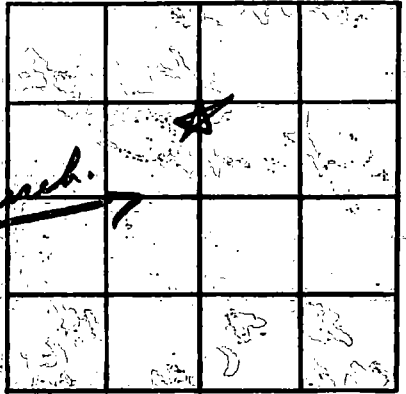

SECTION \_\_\_\_\_

Please indicate well location X.

ADDITIONAL INFORMATION

*Pumped approx 50 gpm  
with base -  
purchased to install  
some pumps here  
can buy wholesale*

If more than one screen, show locations of each on sketch.