

MISSISSIPPI DEPARTMENT OF NATURAL RESOURCES

Bureau of Land and Water Resources

Southport Mall

P.O. Box 10631

Jackson, Mississippi 39209

WATER WELL DRILLERS LOG

Hancock  
~~CA 2106~~  
 2106

April 26 1986 86 Ward Well Dr. Hancock  
 date well completed firm name county well located

LANDOWNER: Jay D. McGuire  
Rt. 3 Box 510  
Pass Christian, ms.  
 (mailing address)

WELL LOCATION:  
 sec. 14 T. 7 N R. 14 E  
10 miles N/E of Rilm  
 (distance) (direction) (nearest town)

WELL PURPOSE: Home  
 (home, irrigation, municipal, industrial)

WELL COMPLETION DATA:

- (1) diameter (inches) 2"
- (2) total depth (feet) 210
- (3) static water level (feet) 25 <sup>below</sup> above top of ground.
- (4) casing PVC 200'  
 (material) (depth)  
 (size) If telescope see back.
- (5) screen 10' -  
 (length) (depth to top)  
2" PVC  
 (size) (material)
- (6) pump owner -  
 (HP) (yield gpm)  
 (type power)
- (7) electric log NO  
 (yes or no)  
N/A  
 (organization running log)
- (8) how well bottom plugged BWU

description of formations encountered	from	to
<u>Sandy - Soil</u>	<u>0</u>	<u>2'</u>
<u>SD</u>	<u>2</u>	<u>21</u>
<u>Clay - silt</u>	<u>21</u>	<u>105</u>
<u>fine SD</u>	<u>105</u>	<u>118</u>
<u>clay - silt</u>	<u>118</u>	<u>184</u>
<u>bone SD</u>	<u>184</u>	<u>210</u>


**RECEIVED**  
 JUN 06 1986

Department of Natural Resources  
 Bureau of Land & Water Resources

DRILLERS REMARKS: N/A

If well telescopes please sketch and show depths.

GROUND LEVEL

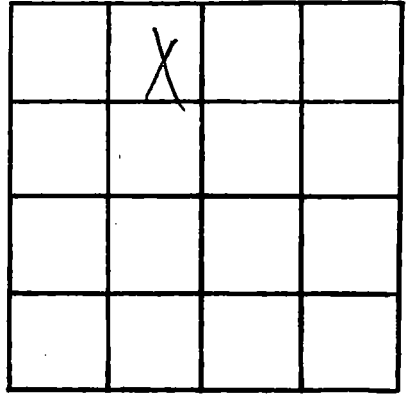

SECTION 14

Please indicate well location X.

ADDITIONAL INFORMATION

If more than one screen, show locations of each on sketch.