

MISSISSIPPI DEPARTMENT OF NATURAL RESOURCES

Bureau of Land and Water Resources

Southport Mall

P.O. Box 10631

Jackson, Mississippi 39209

WATER WELL DRILLERS LOG

Hancock
G-2007
2107

Aug 14 19 86 McMill Pumpwell Hancock
date well completed firm name county well located

LANDOWNER: Jerry Heabe
Rt. 3 Box 452
Pass Christian Ms.
(mailing address)

WELL LOCATION:
sec. 11 T. 7 N. R. 14 E.
4 miles East of Kila
(distance) (direction) (nearest town)

WELL PURPOSE: Home
(home, irrigation, municipal, industrial)


WELL COMPLETION DATA:

- (1) diameter (inches) 2"
- (2) total depth (feet) 260'
- (3) static water level (feet) 30 ^{below} above top of ground.
- (4) casing PVC, 250',
(material) (depth)
2" if telescope see back.
(size)
- (5) screen 12', Bottom
(length) (depth to top)
2", PVC
(size) (material)
- (6) pump 1 10
(HP) (yield gpm)
Electric
(type power)
- (7) electric log NO
(yes or no)

(organization running log)

(8) how well bottom plugged Seal

description of formations encountered	from	to
<u>Mud</u>	<u>0</u>	<u>50</u>
<u>Sand</u>	<u>50</u>	<u>110</u>
<u>Mud</u>	<u>110</u>	<u>180</u>
<u>Sand</u>	<u>180</u>	<u>200</u>
<u>Mud</u>	<u>200</u>	<u>210</u>
<u>Sand</u>	<u>210</u>	<u>260</u>

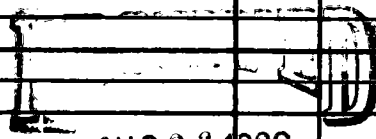


AUG 26 1986

Department of Natural Resources
Bureau of Land & Water Resources

DRILLERS REMARKS:

If well telescopes please sketch and show depths.

GROUND LEVEL

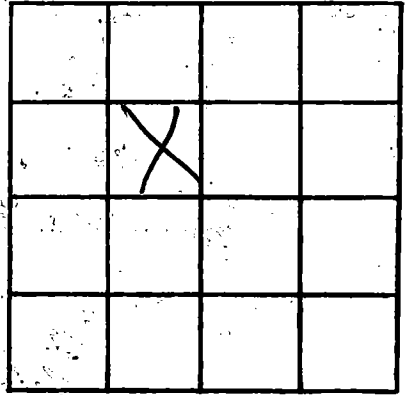

SECTION _____

Please indicate well location X.

ADDITIONAL INFORMATION

If more than one screen,
show locations of each on sketch.