

MISSISSIPPI DEPARTMENT OF NATURAL RESOURCES

Bureau of Land and Water Resources

Southport Mall

P.O. Box 10631

Jackson, Mississippi 39209

WATER WELL DRILLERS LOG

Hancock
 G-3008
 2108

8-14
 date well completed

1986 McGill Pump & Well
 firm name

Hancock
 county well located

LANDOWNER: Byron Roth

description of formations encountered

from

to

genton rd
Pass Christian, Ms.
 (mailing address)

WELL LOCATION:

sec. 15 T. 7 N. R. 14 E.
1 miles East of Kila
 (distance) (direction) (nearest town)

WELL PURPOSE: Home
 (home, irrigation, municipal, industrial)

WELL COMPLETION DATA:

- (1) diameter (inches) 2"
- (2) total depth (feet) 280'
- (3) static water level (feet) 30' below top of ground.
- (4) casing PVC, 270'
 (material) (depth)
2" if telescope see back.
 (size)
- (5) screen 10', Bottom
 (length) (depth to top)
2", PVC
 (size) (material)
- (6) pump 1 10
 (HP) (yield gpm)
Electric
 (type power)
- (7) electric log no
 (yes or no)

(organization running log)

(8) how well bottom plugged Seal

RECEIVED


AUG 26 1986

Department of Natural Resources
 Bureau of Land & Water Resources

DRILLERS REMARKS:

If well telescopes please sketch and show depths.

GROUND LEVEL

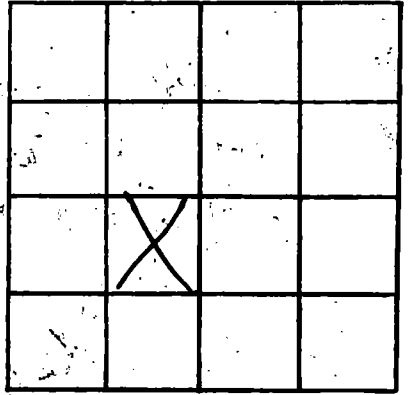

SECTION _____

Please indicate well location X.

ADDITIONAL INFORMATION

If more than one screen, show locations of each on sketch.