

MISSISSIPPI DEPARTMENT OF NATURAL RESOURCES

Bureau of Land and Water Resources

Southport Mall

P.O. Box 10631

Jackson, Mississippi 39209

WATER WELL DRILLERS LOG

Hancock
G 3229
2109

Aug 16 1986 McLill Pump's well Hancock
 date well completed firm name county well located

LANDOWNER: <u>Holcomb Hector</u> <u>8234 Maunala</u>	description of formations encountered	from	to
<u>Bay St. Louis Mo</u> (mailing address)	<u>Sand</u>	<u>0</u>	<u>30</u>
WELL LOCATION: sec. <u>35</u> T. <u>2</u> N. R. <u>14</u> E. (distance) miles (direction) of <u>Downtown Diamond head</u> (nearest town)			
WELL PURPOSE: <u>Irrigation</u> (home, irrigation, municipal, industrial)			
WELL COMPLETION DATA:			
(1) diameter (inches) <u>2"</u>			
(2) total depth (feet) <u>30'</u>			
(3) static water level (feet) <u>2'</u> <u>below</u> top of group.			
(4) casing <u>Pvc</u> , <u>20'</u> , (material) (depth) <u>2"</u> if telescope see back. (size)			
(5) screen <u>10'</u> , <u>Bottom</u> (length) (depth to top)			
<u>2"</u> , <u>Pvc</u> (size) (material)			
(6) pump <u>1/2</u> , <u>8</u> (HP) (yield gpm)			
<u>Electric</u> (type power)			
(7) electric log <u>NO</u> (yes or no)			
(organization running log)			
(8) how well bottom plugged <u>Seal</u>			
DRILLERS REMARKS:			


RECEIVED

AUG 25 1986

Department of Natural Resources
 Bureau of Land & Water Resources

If well telescopes please sketch and show depths.

GROUND LEVEL

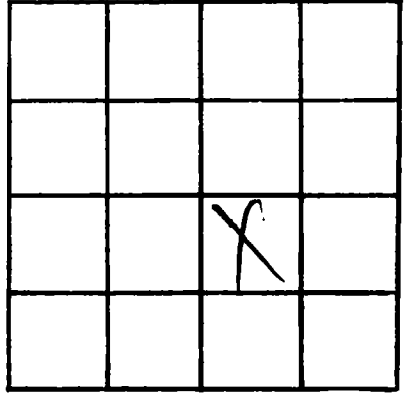

SECTION _____

Please indicate well location X.

ADDITIONAL INFORMATION

If more than one screen,
show locations of each on sketch.