

MISSISSIPPI DEPARTMENT OF NATURAL RESOURCES
Bureau of Land and Water Resources

P.O. Box 10631

Jackson, Mississippi 39209

WATER WELL DRILLERS LOG

COUNTY WELL LOCATED
Hancock

WELL NUMBER CODED
G-3019

DATE WELL COMPLETED
2-11-88

PERMIT NUMBER
0-4193

NAME OF DRILLING FIRM
Bobby Beech's Well Works

NAME & MAILING ADDRESS OF LANDOWNER
Steven Noda

Rt. 2 Box 527-B

Osage Christian MS. 39511

WELL LOCATION: SEC *2* TOWNSHIP *7* RANGE *14*
N *S* *E* *W*

DISTANCE _____ DIRECTION _____ NEAREST TOWN _____

Miles _____ of _____

OTHER LANDMARK _____

WELL PURPOSE: Home Irrigation, Municipal, Industrial, Fish Pond, etc.

PUMP DATA

PUMP TYPE (Circle One):
Submersible, Turbine, Jet, Flowing Well, Other (Describe) _____

POWER TYPE (Circle One):
 Electric, Tractor, Diesel, Gasoline, Butane, Other (Describe) _____

Pump Capacity (GPM)	No. of Stages	Setting Depth
<i>11</i>	<i>2</i>	<i>100</i> FT.

PUMP TEST
Well yielded _____ GPM with
a drawdown of _____ ft.
after _____ hours of pumping

WELL DATA

Well Depth <i>289</i>	Casing Diameter (In.) <i>5"</i>	Casing Length (Ft.) <i>10</i>
Type of Casing <i>PVC</i>	Hole Depth <i>289</i>	Depth to Static Water Level <i>73</i>

TYPE OF COMPLETION: (Circle One or More):
Gravel Packed, Underreamed, Telescoped,
 Natural Development, Open Hole, Other _____

Top of Lap Pipe or Reduction in Casing
FEET _____

IF TELESCOPED OR MORE THAN ONE SCREEN: USE BACK PAGE

LOG DATA

TYPE OF LOG RUN (Circle One):
Electric, Gamma Ray, Density, Sonic, Neutron, No Log Run, Other (Describe) _____

Name of Organization Running Log
Bobby Beech's Well Works

SCREEN DATA

Diameter - Inches <i>5"</i>	Length - Feet <i>20</i>	Slot Size - Inches <i>#8</i>
Screen Type <i>Johnson Screen</i>		Depth to Bottom - Feet <i>289</i>

GEOLOGIC DATA (Office Use Only)

Surface Elev.	Geologic Unit	Unit Thickness	Depth to Top
Subs. SWL	Date	Analysis	Aquifer Test

Driller's Remarks
Fine well

RECEIVED


DESCRIPTION OF FORMATIONS ENCOUNTERED	FROM	TO	FOR NOTATIONS (Continued)	FROM	TO

JUN 6 1989

Department of Natural Resources
Bureau of Land & Water Resources

If well telescopes please
sketch and show depths.

GROUND LEVEL

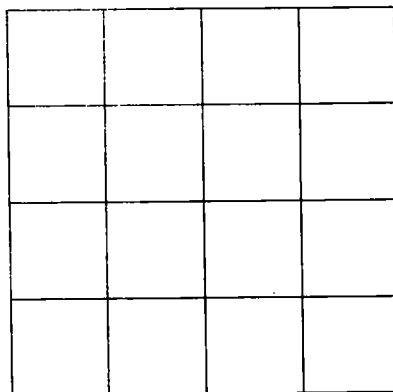

SECTION _____

Please indicate well location X.

ADDITIONAL INFORMATION

WATER SAMPLES
NO. 1

If more than one screen,
show location of each on sketch.