

MISSISSIPPI DEPARTMENT OF NATURAL RESOURCES

Bureau of Land and Water Resources

Southport Mall

P.O. Box 10631

Jackson, Mississippi 39209

WATER WELL DRILLERS LOG

~~LANOCK~~
LANOCK
 CT 3039
 2132

392A

6/12 1989 Bud Penton ~~Order~~ **Doncock**
 date well completed firm name county well located

LANDOWNER: **B. L. Stiles**
Box 603 & 453
 (mailing address)

WELL LOCATION:
 sec. 7 T 2 N R 14 E
4 miles N of Rayden
 (distance) (direction) (nearest town)

WELL PURPOSE: municipal
 (home, irrigation, municipal, industrial)

WELL COMPLETION DATA:
 (1) diameter (inches) 4"
 (2) total depth (feet) 812
 (3) static water level (feet) 8 ^{below} above top of ground.
 (4) casing PVC, 812
 (material) (depth)
4x2 If telescope see back.
 (size)
 (5) screen 15, 797
 (length) (depth to top)
12, PVC
 (size) (material)
 (6) pump _____ (HP) _____ (yield gpm)
 (type power)
 (7) electric log no
 (yes or no)
 (organization running log)
 (8) how well bottom plugged hard

| description of formations encountered | from | to |
|---------------------------------------|------|-----|
| white shale | 0 | 12 |
| white sand | 12 | 30 |
| blue shale | 30 | 60 |
| white sand | 60 | 75 |
| blue shale | 75 | 160 |
| blue sand region | 160 | 175 |
| blue shale | 175 | 780 |
| blue sand | 780 | 811 |

RECEIVED


OCT 15 1989

Department of Natural Resources
 Bureau of Land & Water Resources

DRILLERS REMARKS: no pump furnished

If well telescopes please sketch and show depths.

GROUND LEVEL

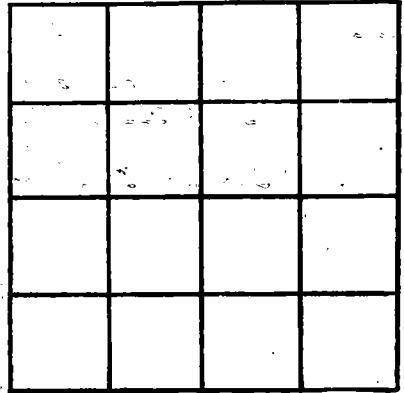

SECTION _____

Please indicate well location X.

ADDITIONAL INFORMATION

If more than one screen, show locations of each on sketch.