

Hancock  
G 302H  
2134

MISSISSIPPI  
 BOARD OF WATER COMMISSIONERS  
 416 North State Street  
 Jackson, Mississippi 39201  
 MISS License # 0-207  
**WATER WELL DRILLERS LOG**  
 M.C. ANTHON

**WATERWELL CONTRACTOR.**

HANCOCK

5-17- 19 89  
 date well completed

Route 2, Box 1425  
**LACOMBE, LOUISIANA 70445**

county well located

LANDOWNER: Ronald Mantel

337 Marina Blvd

Mandeville, La.

504/845-7584 (mailing address)

description of formations encountered

from

to

Clay

0

10

sand

10

35

WELL LOCATION: NE qtr of NE qtr

of sec. 39T 7 S

R 14 W

Clay

35

100

sand

100

125

(distance) miles (direction) of (nearest town)

Clay

125

140

WELL PURPOSE: Domestic  
 (home, irrigation, municipal, industrial)

sand

140

180

WELL COMPLETION DATA:

(1) diameter (inches) 2"

Clay

180

(2) total depth (feet) 180'

(3) static water level (feet) 10 <sup>below</sup> ~~above~~ top of ground.

(4) casing PVC, 155'  
 (material) (depth)

2" if telescope see back.  
 (size)

(5) screen 20', 155 to 175'  
 (length) (depth to top)

2", PVC  
 (size) (material)

(6) pump None  
 (HP) (yield gpm)

(type power)

(7) electric log No  
 (yes or no)

(organization running log)

(8) how well bottom plugged Brick Wash  
Value 175-180

**RECEIVED**


JUN 23 1989

Department of Natural Resources  
 Bureau of Land & Water Resources

DRILLERS REMARKS:

If well telescopes please sketch and show depths.

GROUND LEVEL

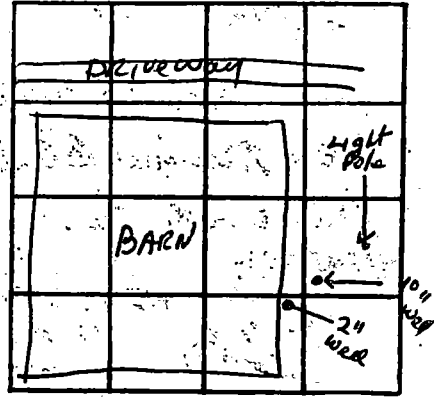

SECTION 39

Please indicate well location X.

ADDITIONAL INFORMATION

If more than one screen, show locations of each on sketch.