

MISSISSIPPI DEPARTMENT OF NATURAL RESOURCES

Bureau of Land and Water Resources

P.O. Box 10631

Jackson, Mississippi 39209

WATER WELL DRILLERS LOG

COUNTY WELL LOCATED Hancock	
WELL NUMBER G	CODED
2135	
DATE WELL COMPLETED 6-12-90	

PERMIT NUMBER 0039
NAME OF DRILLING FIRM Mc Mill

NAME & MAILING ADDRESS OF LANDOWNER Ysabel Storeyphes AIKARD DR. 6515 Diamondhead		
WELL LOCATION: SEC 13 TOWNSHIP 7 N RANGE 14 E (W) Paso Cm., Ms. 39574		
DISTANCE 5 Miles	DIRECTION North of	NEAREST TOWN B.S.L.
OTHER LANDMARK Comm. Center		
WELL PURPOSE (Circle one) <input checked="" type="radio"/> Domestic Irrigation, <input type="radio"/> Municipal, <input type="radio"/> Industrial, <input type="radio"/> Fish Pond, etc.		

PUMP DATA		
PUMP TYPE (Circle One): Submersible, Turbine, <input checked="" type="radio"/> Jet, Flowing Well, Other (Describe) _____		
POWER TYPE (Circle One): Electric, Tractor, Diesel, Gasoline, Butane, Other (Describe) _____		
Pump Capacity (GPM) 15	No. of Stages 2	Setting Depth 90 FT.
PUMP TEST Well yielded 10 GPM with a drawdown of 2 ft. after 1 hours of pumping		

WELL DATA		
Well Depth 300'	Casing Diameter (In.) 2	Casing Length (Ft.) 290
Type of Casing PUC	Hole Depth 300'	Depth to Static Water Level 70'
TYPE OF COMPLETION: (Circle One or More): <input checked="" type="checkbox"/> Gravel Packed, <input type="checkbox"/> Underreamed, <input type="checkbox"/> Telescoped, <input type="checkbox"/> Natural Development, <input type="checkbox"/> Open Hole, <input type="checkbox"/> Other (Describe) _____		
Top of Lap Pipe or Reduction in Casing FEET IF TELESCOPED OR MORE THAN ONE SCREEN: USE BACK PAGE		

LOG DATA	
TYPE OF LOG RUN (Circle One): <input checked="" type="radio"/> No Log Run, <input type="radio"/> Electric, <input type="radio"/> Gamma Ray, <input type="radio"/> Density, <input type="radio"/> Sonic, <input type="radio"/> Neutron, Other (Describe) _____	
Name of Organization Running Log	

SCREEN DATA		
Diameter - Inches 2	Length - Feet 10	Slot Size - Inches .0006
Screen Type sch 40 PUC	Depth to Bottom - Feet 300'	

GEOLOGIC DATA (Office Use Only)			
Surface Elev.	Geologic Unit	Unit Thickness	Depth to Top
Subs. SWL	Date	Analysis	Aquifer Test
Driller's Remarks			

DESCRIPTION OF FORMATIONS ENCOUNTERED	FROM	TO	FORMATIONS (Continued)	FROM	TO
mud	0	20	RECEIVED SEP 23 1991 Dept. of Environmental Quality Bureau of Land & Water Resources		
SAND, mud	20	40			
mud	40	200			
mud, SAND	200	220			
SAND	220	300			

IF MORE SPACE IS NEEDED, USE BACK

If well telescopes please sketch and show depths.


GROUND LEVEL

	X		

SECTION _____

Please indicate well location X.

ADDITIONAL INFORMATION

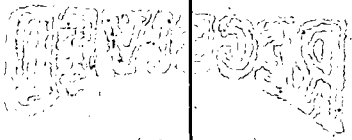

If more than one screen, show location of each on sketch.