

MISSISSIPPI DEPARTMENT OF NATURAL RESOURCES

Bureau of Land and Water Resources

Southport Mall

P.O. Box 10631

Jackson, Mississippi 39209

WATER WELL DRILLERS LOG

H-24  
HANCOCK  
2-28-85

Feb. 28 1985 Ward Well Dly.  
date well completed firm name

Hancock  
county well located

LANDOWNER: Eileen Seltestad  
Dogwood & Tulip St.  
Charlottesville, Va.  
(mailing address)

WELL LOCATION:  
sec. 39 T. 9 N R. 16 E  
5 miles N/W of Charlottesville  
(distance) (direction) (nearest town)

WELL PURPOSE: Home  
(home, irrigation, municipal, industrial)

WELL COMPLETION DATA:

(1) diameter (inches) 2"

(2) total depth (feet) 441

(3) static water level (feet) 3 below top of ground. above

(4) casing PVC 431  
(material) (depth)

- if telescope see back.  
(size)

(5) screen 10' -  
(length) (depth to top)

2" PVC  
(size) (material)

(6) pump - -  
(HP) (yield gpm)

-  
(type power)

(7) electric log NO  
(yes or no)

N/A  
(organization running log)

(8) how well bottom plugged BWV

description of formations encountered	from	to
<u>Clay</u>	<u>0</u>	<u>15</u>
<u>sd</u>	<u>15</u>	<u>28</u>
<u>Clay</u>	<u>28</u>	<u>54</u>
<u>sd - pea gravel</u>	<u>54</u>	<u>68</u>
<u>Clay</u>	<u>68</u>	<u>95</u>
<u>sd</u>	<u>95</u>	<u>124</u>
<u>Clay - silt</u>	<u>124</u>	<u>265</u>
<u>fine sd</u>	<u>265</u>	<u>284</u>
<u>Clay - silt</u>	<u>284</u>	<u>405</u>
<u>Coarse sd</u>	<u>405</u>	<u>441</u>

DRILLERS REMARKS: N/A


**RECEIVED**

APR 10 1985

Department of Natural Resources  
Bureau of Land & Water Resources

If well telescopes please sketch and show depths.

GROUND LEVEL

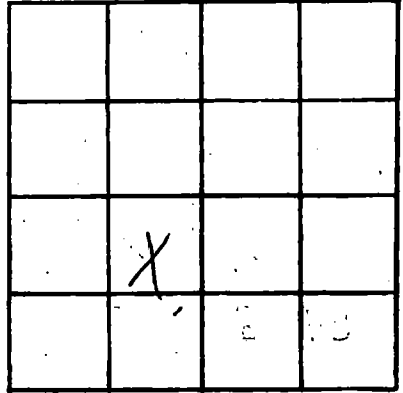

SECTION 39

Please indicate well location X.

ADDITIONAL INFORMATION

If more than one screen, show locations of each on sketch.