

H

WATER WELL DRILLERS LOG

H-300

12-10-60

Date: 12/10, 1960, Driller: Lutter Well Works County Hancock

(Name)

(1) Owner of Land: EARL DAVIS  
 (Name)  
Rt 1 Box 251 - Pecayme, Miss.  
 (Address)

(2) Location: 1/4, 1/4, Sec.      T. R  
     miles in Hainsville of       
 (distance) (direction) (Nearest Town)

(3) Topography: hilly  
 (Hilly) (Flat) (Level)

(4) Purpose of Well: domestic  
 (Domestic Irrigation  
 Municipal, Industrial, Other)

| Description & Color of Materials<br>Sand, Clay, Red Clay, Shell, etc. | Thick-<br>ness<br>Feet | Depth<br>Feet |
|---|------------------------|---------------|
| Clay  | 23                     | 23            |
| Sand  | 24                     | 47            |
| Clay  | 35                     | 82            |
| Sand & gravel   | 53                     | 135           |
| Clay  | 177                    | 312           |
| Sand  | 92                     | 404           |
| Clay  | 36                     | 440           |
| Sand  | 28                     | 468           |
| Clay  | 54                     | 522           |
| Sand  | 74                     | 596           |
| Clay  | 289                    | 885           |
| Sand  | 49                     | 934           |

Information upon completion of well:

(1) Diameter 2 inches.

(2) Total Depth 934 feet.

(3) Water Level 50 feet above top of ground.

(4) Cased to all, Size 2"


(5) Screen: Size 2", Length 20'

(6) Were any formations sealed against pollution?  
     yes,  no.

If YES depth of formation     

Why     

Drillers Remarks:     

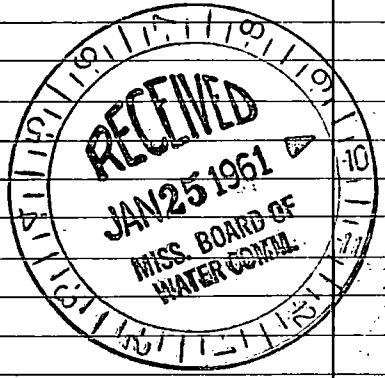

(Use Back Side)

Well No.

| Year       | 1950 | 1951 | 1952 | 1953 | 1954 | 1955 | 1956 | 1957 | 1958 | 1959 | 1960 |
|------------|------|------|------|------|------|------|------|------|------|------|------|
| Population | 100  | 105  | 110  | 115  | 120  | 125  | 130  | 135  | 140  | 145  | 150  |
| Area       | 100  | 105  | 110  | 115  | 120  | 125  | 130  | 135  | 140  | 145  | 150  |
| ...        | ...  | ...  | ...  | ...  | ...  | ...  | ...  | ...  | ...  | ...  | ...  |

1950 1951 1952 1953 1954 1955 1956 1957 1958 1959 1960

1950  
1951  
1952  
1953  
1954  
1955  
1956  
1957  
1958  
1959  
1960