

Hancock  
H12  
2-67  
Elec Log

MISSISSIPPI  
BOARD OF WATER COMMISSIONERS  
416 North State Street  
Jackson, Mississippi 39201

WATER WELL DRILLERS LOG

2-21 1967 SUTTER Well Works Hancock  
date well completed firm name county well located

LANDOWNER: NASA  
U.S. GEOLOGICAL SURVEY  
Jackson, Miss.  
(mailing address)


description of formations encountered	from	to
Clay	0	16
sand	16	19
Clay	19	22
sand	22	40
Clay	40	62
sand	62	147
Clay	147	185
sand	185	190
Clay	190	220
sand	220	320
Clay	320	325
sand	325	372
Clay	372	377
sand	377	431
Clay	431	458
sand	458	490
Clay	490	514
sand	514	601

WELL LOCATION:  
T 8 R 16  
S S W  
1.3 miles S of Picayune  
(distance) (direction) (nearest town)

WELL PURPOSE: Test  
(home, irrigation, municipal, industrial)

WELL COMPLETION DATA:

- (1) diameter (inches) 4x6
- (2) total depth (feet) 601
- (3) static water level (feet) 89 below top of ground
- (4) casing Steel 571' (material) (depth)  
4x6 (size) if telescope see back.
- (5) screen 30' 571' (length) (depth to top)  
4" (size) Galvanized (material)
- (6) pump none (HP) (yield gpm)  
(type power)
- (7) electric log Yes (yes or no)  
USGS (organization running log)
- (8) how well bottom plugged BP Value

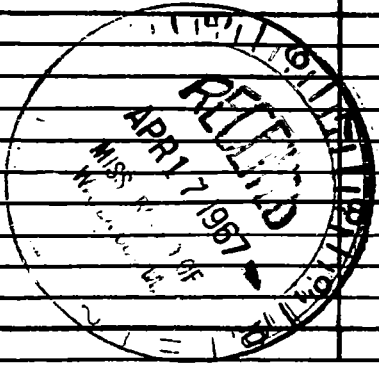

DRILLERS REMARKS:

If well telescopes please sketch and show depths.

H12

GROUND LEVEL

105' of 6" Black Steel

Vertical list of handwritten notes on the left side of the well diagram.

Vertical list of handwritten notes on the right side of the well diagram.

30' strainer to bottom of sand strata

		*	
		<del>*</del>	



SECTION 15

Please indicate well location X.

ADDITIONAL INFORMATION

Series of horizontal lines for recording additional information, with some faint handwritten notes.

If more than one screen, show locations of each on sketch.