

**MISSISSIPPI  
BOARD OF WATER COMMISSIONERS**  
416 North State Street  
Jackson, Mississippi 39201

**WATER WELL DRILLERS LOG**

Hancock  
H 13  
3-67  
Elec Log

2-28 1967 SUTTER Well Works HANCOCK  
date well completed firm name county well located

LANDOWNER: NASA  
U.S. GEOLOGICAL SURVEY  
JACKSON Miss.  
(mailing address)

WELL LOCATION:  
sec. 8 15 8 W R. 16 W  
13 miles S of Picayune  
(distance) (direction) (nearest town)

description of formations encountered	from	to
Clay	0	16
sand	16	19
Clay	19	25
sand	25	43
Clay	43	63
sand	63	148
Clay	148	215
sand	215	265
Clay	265	270
sand	270	370
Clay	370	385
sand	385	435
Clay	435	444
sand	444	494

WELL PURPOSE: TEST  
(home, irrigation, municipal, industrial)

WELL COMPLETION DATA:

(1) diameter (inches) 4 x 6

(2) total depth (feet) 494

(3) static water level (feet) 56 <sup>below</sup> above top of ground.

(4) casing Steel 464  
(material) (depth)

4 x 6 if telescope see back.  
(size)

(5) screen 30' 464  
(length) (depth to top)

4" GALVANIZED  
(size) (material)

(6) pump None  
(HP) (yield gpm)


(type power)

(7) electric log yes  
(yes/no)

USGS  
(organization running log)

(8) how well bottom plugged B.P. Valve

DRILLERS REMARKS:

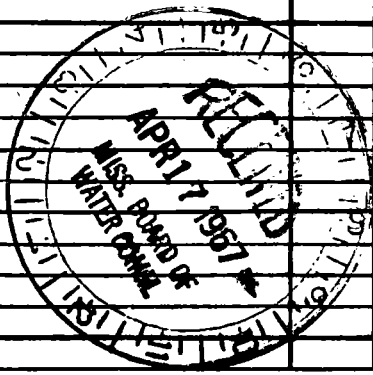

If well telescopes please sketch and show depths.


H 13

GROUND LEVEL

105' of 6" black  
steel pipe

359' of 4" black  
steel pipe

30' of strainer to  
bottom of sand  
strata

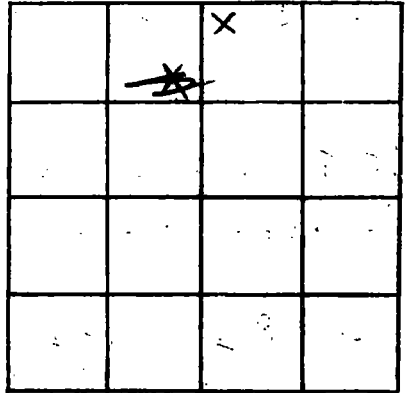

SECTION 315

Please indicate well location X.

ADDITIONAL INFORMATION

If more than one screen,  
show locations of each on sketch.