

HANCOCK
H 23

7-6-79

E log # 71

7-6-79

date well completed

MISSISSIPPI
BOARD OF WATER COMMISSIONERS
416 North State Street
Jackson, Mississippi 39201

WATER WELL DRILLERS LOG

CODED

Switzer well Co.
firm name

HANCOCK
county well located

LANDOWNER	description of formations encountered	from	to
STATE Hwy. Dept.	SAND & CLAY & CLAY	0	23
HOSPITALITY STATION	CLAY & SAND STREAKS	23	43
I-10-1007 Interchange	SAND & CLAY	43	82
(mailing address)	CLAY & SAND & GRAVEL	82	102
	CLAY	102	142
	SAND	142	162
	SAND WITH CLAY STREAK	162	190
	CLAY	190	220
	SAND	220	262
	CLAY	262	282
	CLAY & SAND STREAKS	282	300
	CLAY	300	360
	CLAY & SHALE	360	388
	CLAY	388	423
	CLAY & SAND STREAK	423	452
	SAND FINE	452	469
	CLAY	469	529
	SAND FINE	529	587
	CLAY	587	652
	SAND FINE	652	737
	SAND & IRON GRAVEL	737	768

WELL LOCATION:

sec 28 T 8 N R 16 E
4 miles N of Pearlinton
(distance) (direction) (nearest town)

WELL PURPOSE:

(home, irrigation, municipal, industrial)

WELL COMPLETION DATA:

- (1) diameter (inches) 6x4
- (2) total depth (feet) 765
- (3) static water level (feet) 2' below top of ground
- (4) casing Steel 725' (material) (depth)
6x4 (size) If telescope see back.
- (5) screen 40' 725' (length) (depth to top)
4" Stainless Steel (size) (material)
- (6) pump 5 90 (HP) (yield gpm)
AC (type power)
- (7) electric log YES (yes or no)
MSGS oct 74 (organization running log)
- (8) how well bottom plugged METAL BACKWASH


DRILLERS REMARKS:

Miss. Board of Water Comm.

JUL 6 1979

RECEIVED

If well telescopes please sketch and show depths.

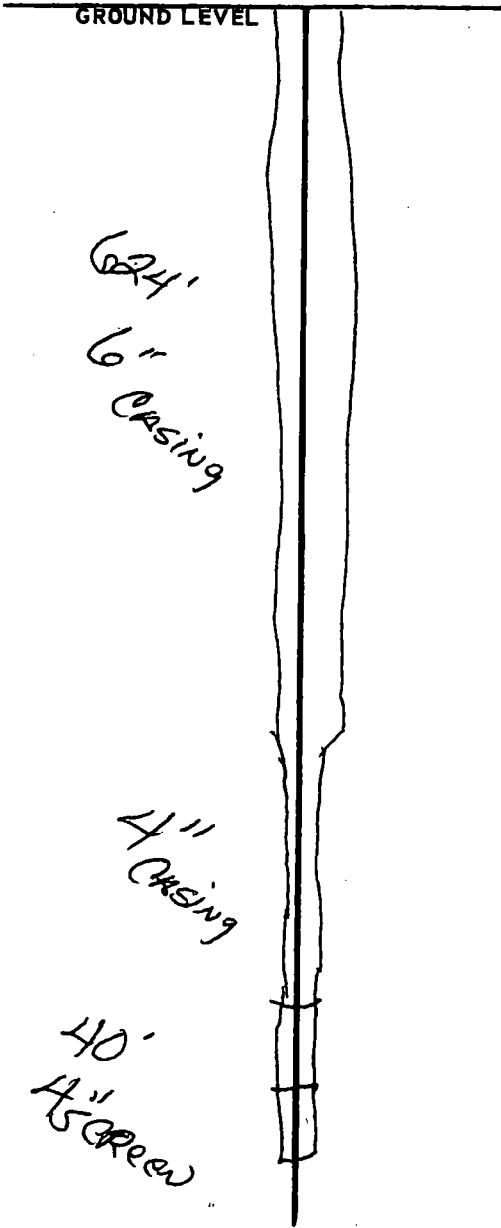

X			

SECTION 28

Please indicate well location X.

ADDITIONAL INFORMATION

If more than one screen, show locations of each on sketch.