

H 2000
7-22-60

WATER WELL DRILLERS LOG

(?)

Date: 7-22 1960, Driller: Juck Bruce County P.R.
(Name)

- (1) Owner of Land: Mr La Combe
(Name)
Dainsville Miss
(Address)
- (2) Location: $\frac{1}{4}$, $\frac{1}{4}$, Sec. T R
 miles, of (Nearest Town)
(distance) (direction)
- (3) Topography:
(Hilly) (Flat) (Level) ✓
- (4) Purpose of Well: Fishing Camp
(Domestic Irrigation, Municipal, Industrial, Other)

Description & Color of Materials Sand, Clay, Red Clay, Shell, etc.	Thick- ness Feet	Depth Feet
Sand + gravel	0	50
Blue clay "hard"	50	227
grey sand.	227	257


Information upon completion of well:

- (1) Diameter 2 inches.
- (2) Total Depth 257 feet.
- (3) Water Level Flow feet below top of ground.
- (4) Cased to , Size .
- (5) Screen: Size 2", Length 5'.
- (6) Were any formations sealed against pollution?
 yes, No no.

257
Total Depth

If YES depth of formation
Why

Drillers Remarks: 35 gal
Per + 10 lbs
Pressure

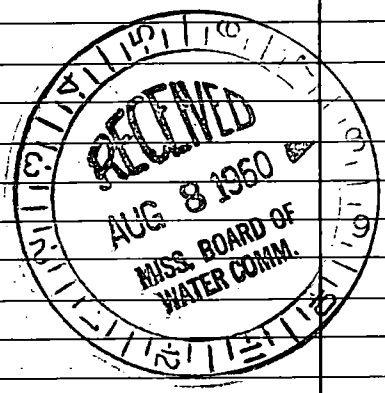

Well No. 4

(Use Back Side)

Table with multiple columns and rows, containing illegible data due to extreme image noise and low resolution.