

H 2001
7-23-60

WATER WELL DRILLERS LOG

(?)

Date: 7-23, 1960, Driller: Quick & Sons County P.R.
(Name)

(1) Owner of Land: David Richard
(Name)
Sainerville Miss
(Address)

(2) Location: 1/4, 1/4, Sec. T R
 miles, of
(distance) (direction) (Nearest Town)

(3) Topography: (Level)
(Hilly) (Flat)

(4) Purpose of Well: Fishing Camp
(Domestic, Irrigation, Municipal, Industrial, Other)

Description & Color of Materials Sand, Clay, Red Clay, Shell, etc.	Thick- ness Feet	Depth Feet
<u>Sand</u>	<u>0</u>	<u>30</u>
<u>Blue clay</u>	<u>30</u>	<u>228</u>
<u>good sand</u>	<u>228</u>	<u>259</u>

Information upon completion of well:

(1) Diameter 2 inches.

(2) Total Depth 259 feet.

(3) Water Level Flow feet below top of ground.

(4) Cased to , Size .


(5) Screen: Size 2", Length 5'.

(6) Were any formations sealed against pollution?
 yes, No no.

259'
Total Depth

If YES depth of formation
Why

Drillers Remarks: 35 gal Per
10 lbs Pressure

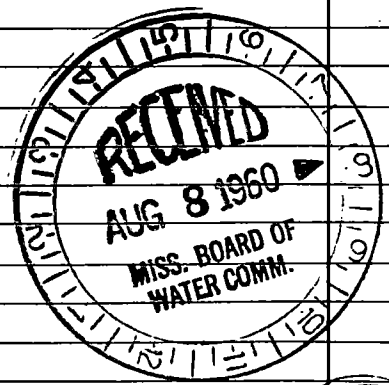

Well No. 5

(Use Back Side)

