

HANCOCK

H 2002  
10-30-60

WATER WELL DRILLERS LOG

Date: 10-30-1960, Driller Quick & Grace county Pointe Rivier  
(Name)

(1) Owner of Land Garman Lundrum  
(Name)  
Napoleon Miss  
(Address)

(2) Location: 1/4, 1/4, Sec. 28, T. 16N, R. 10W  
7 miles North Washington  
(distance) (direction) (Nearest Town)

(3) Topography: \_\_\_\_\_  
(Hilly) (Flat) (Level)

(4) Purpose of Well: Domestic  
(Domestic Irrigation  
Municipal, Industrial, Other)

Description & Color of Materials Sand, Clay, Red Clay, Shell, etc.	Thick- ness Feet	Depth Feet
Surface Clay	0	20
Soil + gravel	20	90
Blue Clay	90	150
grey sand	150	200
Blue Clay	200	310
good sand	310	400
Blue Clay	400	570
good sand	570	725
Blue Clay	725	930
good sand	930	970
Blue clay	970	1210
good sand	1210	1270

Information upon completion of well:

(1) Diameter 2 inches.

(2) Total Depth 1270 feet.

(3) Water Level Flow feet below top of ground.

(4) Cased to \_\_\_\_\_, Size \_\_\_\_\_

(5) Screen: Size 2", Length 20'


(6) Were any formations sealed against pollution?  
\_\_\_\_\_ yes, No no.

1270  
total Depth

If YES depth of formation \_\_\_\_\_

Why \_\_\_\_\_

Drillers Remarks: 38 lbs  
Pressure.

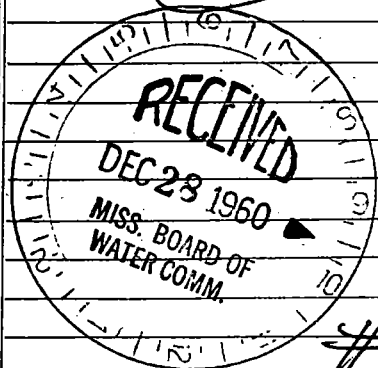

#30

(Use Back Side)

Well No.

