

HANCOCK

H 2003  
4-12-61

WATER WELL DRILLERS LOG

H

Hancock  
~~276~~

Date: 4-12, 1961, Drillers: Quick + Price County: Hancock  
(Name)

(1) Owner of Land: Joe Miller  
(Name)  
Napoleon Miss.  
(Address)

(2) Location: 1/4, 1/4, Sec. 28 9 1/4  
T 14 R 14  
7 miles North, of Parisington  
(distance) (direction) (Nearest Town)

(3) Topography: X  
(Hilly) (Flat) (Level)

(4) Purpose of Well: Domestic  
(Domestic Irrigation  
Municipal, Industrial, Other)

Description & Color of Materials Sand, Clay, Red Clay, Shell, etc.	Thick- ness Feet	Depth Feet
Surface Clay	0	10
Sand + gravel	10	110
Clay	110	240
Sand "Good Pump"	240	290
Blue Clay	290	380
good sand	380	500
Hard Blue clay	500	600
Good Sand	600	683

Information upon completion of well:

(1) Diameter 2 inches.

(2) Total Depth 683 feet.

(3) Water Level Flow feet below top of ground.

(4) Cased to \_\_\_\_\_, Size \_\_\_\_\_.


(5) Screen: Size 2", Length 20'.

(6) Were any formations sealed against pollution?  
\_\_\_\_\_ yes, X no.

683

If YES depth of formation \_\_\_\_\_  
Why \_\_\_\_\_

Drillers Remarks: 25 gal per  
8 lbs Pressure -

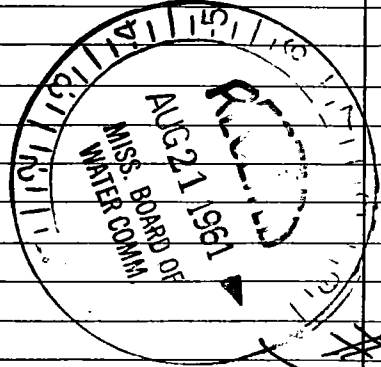

#57

(Use Back Side)

Well No.

