

H 9004  
7-25-61

WATER WELL DRILLERS LOG

H Hancock  
P.R.

Date: 7-25, 1961, Driller: Jucks + Grace County

(Name)

(1) Owner of Land: W.C. Burkhardt  
(Name)  
Napoleon Miss.  
(Address)

(2) Location: 1/4, 1/4, Sec. 8 T6 R14,  
5 miles North of Princeton  
(distance) (direction) (Nearest Town)

(3) Topography: V  
(Hilly) (Flat) (Level)

(4) Purpose of Well: Domestic  
(Domestic Irrigation  
Municipal, Industrial, Other)

Description & Color of Materials Sand, Clay, Red Clay, Shell, etc.	Thick- ness Feet	Depth Feet
<u>Surface Clay</u>	<u>0</u>	<u>15</u>
<u>" " Sand</u>	<u>15</u>	<u>150</u>
<u>Clay</u>	<u>150</u>	<u>280</u>
<u>Sand</u>	<u>280</u>	<u>350</u>
<u>Clay</u>	<u>350</u>	<u>690</u>
<u>good - Sand</u>	<u>690</u>	<u>756</u>

Information upon completion of well:

(1) Diameter 2 inches.

(2) Total Depth 756 feet.

(3) Water Level Flw feet below top of ground.

(4) Cased to \_\_\_\_\_, Size \_\_\_\_\_

(5) Screen: Size 2", Length 20'


(6) Were any formations sealed against pollution?  
\_\_\_\_\_ yes, X no.

756

If YES depth of formation \_\_\_\_\_

Why \_\_\_\_\_

Drillers Remarks: Fair well  
10 lbs  
3.5 gal Per -

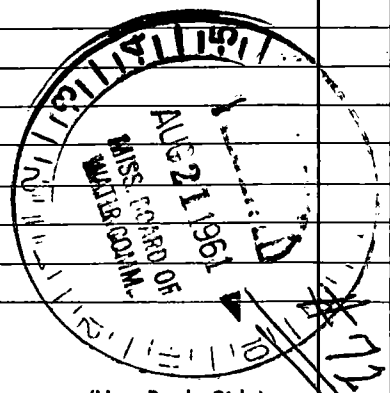

(Use Back Side)

Well No.

