

HANCOCK MISSISSIPPI BOARD OF WATER COMMISSIONERS

H 2006


7-64

WATER WELL DRILLERS LOG

Date: July, 1964, Driller: Carloss Well Supply County: Hancock
(Name)

	Description & Color of Materials Sand, Clay, Red Clay, Shell, etc.	Thick- ness Feet	Depth Feet
(1) Owner of Land: <u>U.S. Army - Corps of Engineers -</u> <small>(Name)</small>			
<u>Miss. Test Facility, Miss.</u> <small>(Address)</small>			
(2) Location: <u>Potable Water Well # 2</u> <u>_____ 1/4, _____ 1/4, Sec. _____ T. R. _____</u>			
<u>_____ miles _____ of _____</u> <small>(distance) (direction) (Nearest Town)</small>			
(3) Topography: <u>Flat</u> <small>(Hilly) (Flat) (Level)</small>			
(4) Purpose of Well: <u>Industrial</u> <small>(Domestic Irrigation, Municipal, Industrial, Other)</small>			
Information upon completion of well:			
(1) Diameter <u>12"</u> inches.			
(2) Total Depth <u>1481</u> feet.			
(3) Water Level <u>Plus 78.5</u> feet below top of ground.			
(4) Cased to <u>1420'</u> , Size <u>12"</u>			
(5) Screen: Size <u>8"</u> , Length <u>63'</u>			
(6) Were any formations sealed against pollution?			
<u>X</u> yes, _____ no.			
If YES depth of formation <u>Cemented Casing</u>			
Why _____			
Drillers Remarks: _____			

SEE ATTACHED FORMATION TEST DATA SHEET

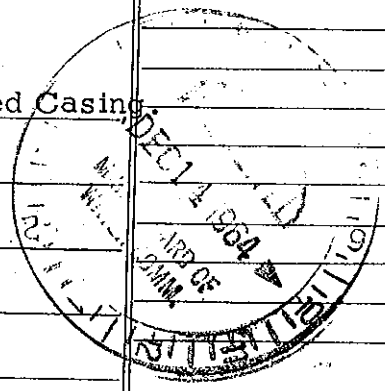

(Use Back Side)

Well No.

Mail this copy to Board of Water Commissioners 429 Miss. St. Jackson, Miss.

Hancock Co
H2006

Section of the Hancock Co. ...
... Hancock Co. ...

DEPTH	THICKNESS	DESCRIPTION
1208	36'	Coarse Sand with Shale Strata
1212	8'	Sandy Shale
1224	10'	Sand
1234	35'	Sandy Shale
1234	10'	Sand
1248	65'	Sandy Shale
1308	8'	Sand
1327	89'	Hard Shale with Sand Streaks
1331	18'	Sandy Shale
1343	60'	Sand
1370	17'	Shale

Hancock Co.
H 2006

FORMATION LOG FOR ... (Site: Army Eng. District, Mobile, Miss. Test Facility)

TEST HOLE ADDRESS ... (Missile or Test Facility - Mississippi)

TEST HOLE LOCATION ... (Potlusa Water Well # 2)

FORMATION AND TEST HOLE INFORMATION

TOTAL DEPTH	THICKNESS EACH STRATUM	FORMATION	REMARKS
	11'	Top Soil	
10'	5'	Fine Sand	
54'	48'	Sand with Streaks of Clay	
90'	26'	Sandy Clay	
140'	50'	Sand and Gravel	
174'	34'	Clay	
197'	23'	Sandy Clay	
215'	18'	Clay	
305'	90'	Sandy Clay	
334'	29'	Sand	
339'	5'	Sandy Clay	
382'	43'	Sand	
394'	12'	Sandy Clay	
428'	34'	Clay	
439'	11'	Sandy Clay	
532'	93'	Clay	
603'	71'	Sand	
608'	5'	Clay	
710'	102'	Coarse Sand	
746'	36'	Clay	
857'	111'	Sandy Clay	
903'	46'	Sand (Coarse)	
1102'	199'	Sandy Shale	