

HANCOCK

MISSISSIPPI BOARD OF WATER COMMISSIONERS

H. 2089

6-66

WATER WELL DRILLERS LOG

HANCOCK

Date: 6-8-, 1966, Driller: NEIL LUMPKIN County: PEARL RIVER

(Name)

(1) Owner of Land: Actron (Name)

NASA (Address)

(2) Locations: SW 1/4, SW 1/4, Sec. 30 T16 R5

7 miles South of Picayune (distance) (direction) (Nearest Town)

(3) Topography: Flat (Hilly) (Flat) (Level)

(4) Purpose of Well: Supply for Trailers (Domestic Irrigation) (Municipal, Industrial, Other)

Description & Color of Materials Sand, Clay, Red Clay, Shell, etc.	Thick- ness Feet	Depth Feet
Surface Clay	0	10
" sand	10	40
Blue clay	40	100
Sand & "little rocks"	100	132

Information upon completion of well:

(1) Diameter 2 inches.

(2) Total Depth 132 feet.

(3) Water Level 40 feet below top of ground.

(4) Cased to _____, Size _____


(5) Screen: Size 3", Length 5'

(6) Were any formations sealed against pollution? _____ yes, _____ no.

If YES depth of formation _____

Why _____

Drillers Remarks: _____

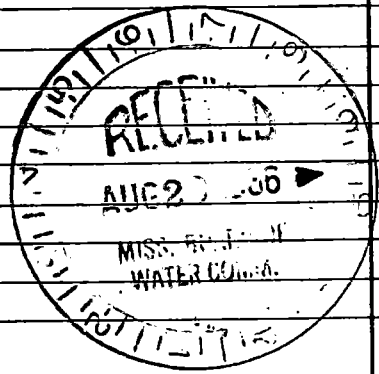

(Use Back Side)

Well No.

