

Hancock  
H 2013  
5-68  
USGS

MISSISSIPPI  
BOARD OF WATER COMMISSIONERS  
416 North State Street  
Jackson, Mississippi 39201

WATER WELL DRILLERS LOG

5-7 1968 Jetter Well Works Hancock  
date well completed firm name county well located

LANDOWNER: U.S. GOVT.

NASA

(mailing address)

WELL LOCATION:

sec. 3 T 8 S R 16 E  
13 miles S of Picayune  
(distance) (direction) (nearest town)

WELL PURPOSE: Observation  
(home, irrigation, municipal, industrial)

WELL COMPLETION DATA:

(1) diameter (inches) 2  
(2) total depth (feet) 135  
(3) static water level (feet) 6 below above top of ground.

(4) casing black steel 85'  
(material) (depth)

2"  
(size) if telescope see back.

(5) screen 50' , 85'  
(length) (depth to top)

2" , galv.  
(size) (material)

(6) pump none  
(HP) (yield gpm)

(type power)

(7) electric log yes  
(yes or no)

U.S.G.S.  
(organization running log)

(8) how well bottom plugged B.P. Value


DRILLERS REMARKS:

description of formations encountered

from


to

0 16  
16 47  
47 76  
76 135

JUN 24 1968  
MISS. BD. OF  
WATER COM. 

If well telescopes please sketch and show depths.

GROUND LEVEL

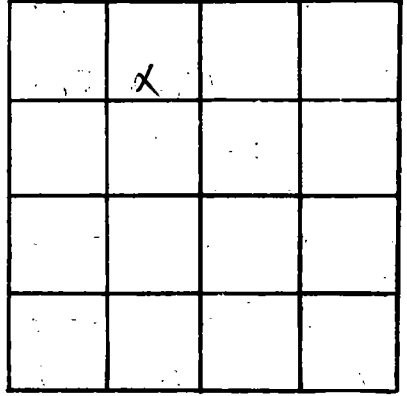

SECTION 3

Please indicate well location X.

ADDITIONAL INFORMATION

---

---

If more than one screen, show locations of each on sketch.