

MISSISSIPPI DEPARTMENT OF NATURAL RESOURCES
Bureau of Land and Water Resources
 Southport Mall
 P.O. Box 10631
 Jackson, Mississippi 39209
WATER WELL DRILLERS LOG

Hancock
H 90 B

12-21-84 19 Walker Welding Hancock
 date well completed firm name county well located

LANDOWNER: U.S. Government
Log U.S. Navy ?
NST A Building 2434
 (mailing address)

WELL LOCATION:
 sec. 30 T 8 N R 16 E
 (distance) miles (direction) of (nearest town)

WELL PURPOSE: U.S. NAVY LABS
 (home, irrigation, municipal, industrial)

WELL COMPLETION DATA:

- (1) diameter (inches) 2"
- (2) total depth (feet) 310'
- (3) static water level (feet) 12 below top of ground.
- (4) casing PVC 290'
 (material) (depth)
 (size) if telescope see back.
- (5) screen 10 290'
 (length) (depth to top)
 (size) (material)
- (6) pump 1 8
 (HP) (yield gpm)
Elec
 (type power)
- (7) electric log (yes or no) _____
 (organization running log)
- (8) how well bottom plugged Sand
Gravel


description of formations encountered	from	to
Clay	0	16
Sand	16	72
Blue shell	72	153
Sand	153	165
Blue shale	165	180
Sand	180	192
Blue shale	192	265
Sand	265	273
Blue shale	273	283
Coar. sand	283	303
Blue shale	303	310

DRILLERS REMARKS:
10' pipe below
seam

1/21/85

If well telescopes please sketch and show depths.

GROUND LEVEL

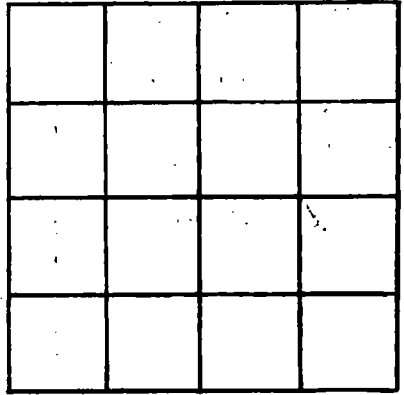

SECTION _____

Please indicate well location X.

ADDITIONAL INFORMATION

If more than one screen, show locations of each on sketch.