

MISSISSIPPI DEPARTMENT OF NATURAL RESOURCES

Bureau of Land and Water Resources

Southport Mall

P.O. Box 10631

Jackson, Mississippi 39209

WATER WELL DRILLERS LOG

Hancock
H 2019

1-10
date well completed

1986 PENTON WELL SERV.
firm name

HANCOCK
county well located

LANDOWNER: NSTL
NSTL, Bay St. Louis
MS.
(mailing address)

WELL LOCATION:
sec. 30 T 8 S R. 16 W
0 miles (distance) of NSTL (nearest town)

WELL PURPOSE: HOME - CLUB
(home, irrigation, municipal, industrial)

WELL COMPLETION DATA:

(1) diameter (inches) 2"

(2) total depth (feet) 670'

(3) static water level (feet) Flow below above top of ground.

(4) casing PVC (material), 660' (depth)
2" (size) if telescope see back.

(5) screen 10" (length), 660' (depth to top)
2" (size), PVC (material)

(6) pump 1/2 (HP), (yield gpm)
Elec (type power)

(7) electric log NO (yes or no)
(organization running log)

(8) how well bottom plugged B.W.

| description of formations encountered | from | to |
|---------------------------------------|------|-----|
| CLAY | 0 | 30 |
| SAND | 30 | 75 |
| BLUE CLAY | 75 | 315 |
| SAND | 315 | 340 |
| BLUE CLAY | 340 | 470 |
| SILT | 470 | 530 |
| BLUE CLAY | 530 | 580 |
| SAND | 580 | 670 |


RECEIVED
JAN 30 1986

Department of Natural Resources
Bureau of Land & Water Resources

DRILLERS REMARKS:

If well telescopes please
sketch and show depths.

GROUND LEVEL

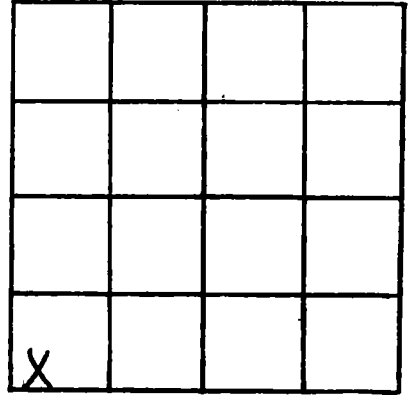

SECTION 30

Please indicate well location X.

ADDITIONAL INFORMATION

If more than one screen,
show locations of each on sketch.