

HANCOCK
J 21
3-8-75

MISSISSIPPI
BOARD OF WATER COMMISSIONERS
 416 North State Street
 Jackson, Mississippi 39201

CODED

WATER WELL DRILLERS LOG

3-8- 1975 Ward Well Dlg. Hancock
 date well completed firm name county well located

LANDOWNER: Frank Schivo
Leel St.
Bay St. Louis, missi
 (mailing address)

description of formations encountered	from	to
<u>clay-fill</u>	<u>0</u>	<u>17</u>
<u>sd</u>	<u>17</u>	<u>45</u>
<u>Grey clay</u>	<u>45</u>	<u>60</u>
<u>clay-shell</u>	<u>60</u>	<u>95</u>
<u>fine sd</u>	<u>95</u>	<u>115</u>
<u>clay</u>	<u>115</u>	<u>132</u>
<u>Red gravel-sd</u>	<u>132</u>	<u>152</u>

WELL LOCATION:
 sec. 32 T. 2 N. R. 15 E.
8 miles W of B.S.L.
 (distance) (direction) (nearest town)


WELL PURPOSE: Home
 (home, irrigation, municipal, industrial)

WELL COMPLETION DATA:

- (1) diameter (inches) 2"
- (2) total depth (feet) 152
- (3) static water level (feet) 2 below above top of ground.
- (4) casing PVC, 147'
 (material) (depth)
 (size) If telescope see back.
- (5) screen 5', -
 (length) (depth to top)
2", PVC
 (size) (material)
- (6) pump -, -
 (HP) (yield gpm)
 (type power)
- (7) electric log NO
 (yes or no)
N/A
 (organization running log)
- (8) how well bottom plugged B.W.V.

CODED


DRILLERS REMARKS: N/A

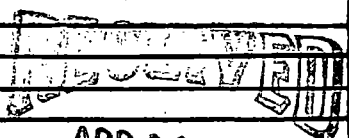

APR 29 1975

If well telescopes please sketch and show depths.

GROUND LEVEL

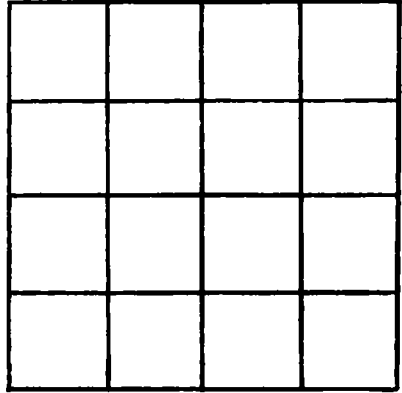

SECTION 32

Please indicate well location X.

ADDITIONAL INFORMATION

If more than one screen,
show locations of each on sketch.