

J23

3-19-65

13S

WATER WELL DRILLERS LOG

CODED

A

Date: 3-19, 1965, Driller: Sutter Well Works County Hancock

(Name)

(1) Owner of Land: Geo. H. Shubert
 (Name)
Bay St. Louis
 (Address)

(2) Location: NW 1/4, SE 1/4, Sec. 13 T. 88 R. 15 W
7 miles W of Bay
 (distance) (direction) (Nearest Town)

(3) Topography: flat
 (Hilly) (Flat) (Level)

(4) Purpose of Well: domestic
 (Domestic Irrigation
 Municipal, Industrial, Other)

Description & Color of Materials Sand, Clay, Red Clay, Shell, etc.	Thick- ness Feet	Depth Feet
Clay	30	30
sand	15	45
Clay	45	90
sand	47	137
Clay	31	168
sand	128	296
Clay	126	422
CODED	28	450
Clay-sand streaks	170	620
sand	117	737

Information upon completion of well:

(1) Diameter 2 inches.

(2) Total Depth 737 feet.

(3) Water Level + 35 feet above top of ground.

(4) Cased to all, Size 2"


(5) Screen: Size 2", Length 20'

(6) Were any formations sealed against pollution?
 _____ yes, no.

If YES depth of formation _____

Why _____

Drillers Remarks: _____

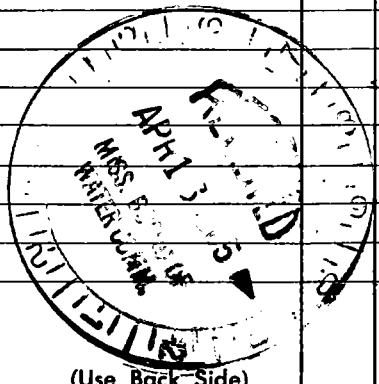

(Use Back Side)

Well No.

