

HANCOCK
J 24

MISSISSIPPI BOARD OF WATER COMMISSIONERS

12-7-65 135 WATER WELL DRILLERS LOG

Date: 12-7, 1965, Driller: Sutter Well Works County Hancock

CODED

(Name)

(1) Owner of Land: Tom Yarger
(Name)

4729 Casina St. - N.O. La
(Address)

(2) Location: SE 1/4, SE 1/4, Sec. 35 T85 R15 W

4 miles N of Lakeshore
(distance) (direction) (Nearest Town)

(3) Topography: flat
(Hilly) (Flat) (Level)

(4) Purpose of Well: domestic
(Domestic Irrigation
Municipal, Industrial, Other)

Description & Color of Materials
Sand, Clay, Red Clay, Shell, etc.

Thick-
ness
Feet

Depth
Feet

<u>sand</u>	<u>35</u>	<u>35</u>
<u>Clay - sand streaks</u>	<u>97</u>	<u>132</u>
<u>Sand + gravel</u>	<u>21</u>	<u>153</u>
<u>Clay</u>	<u>24</u>	<u>177</u>
<u>sand</u>	<u>58</u>	<u>235</u>
<u>Clay - sand streaks</u>	<u>365</u>	<u>600</u>
<u>sand</u>	<u>12</u>	<u>612</u>
<u>Clay</u>	<u>60</u>	<u>672</u>
<u>sand</u>	<u>14</u>	<u>686</u>
<u>Clay</u>	<u>48</u>	<u>734</u>
<u>sand</u>	<u>91</u>	<u>825</u>

CODED


Information upon completion of well:

- (1) Diameter 3 inches.
- (2) Total Depth 825 feet.
- (3) Water Level + 20 feet above below top of ground.
- (4) Cased to all, Size 3"
- (5) Screen: Size 3", Length 20'
- (6) Were any formations sealed against pollution?
 yes, no.

If YES depth of formation _____

Why _____

Drillers Remarks: _____

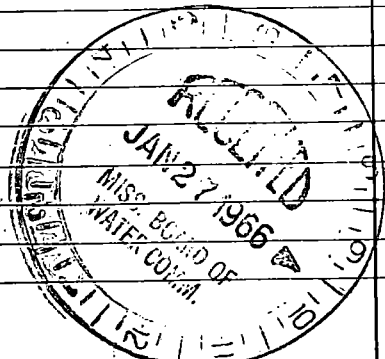

(Use Back Side)

Well No.

Handwritten header text, possibly a title or date, located at the top of the page.

Main body of handwritten text, appearing to be a list or a series of entries, possibly including names and dates.

Handwritten text located in the lower right quadrant of the page, possibly a signature or a note.