

HANCOCK
J 27
7-5-77

MISSISSIPPI
BOARD OF WATER COMMISSIONERS
416 North State Street
Jackson, Mississippi 39201

CODED

WATER WELL DRILLERS LOG

July 5 1977 Sutter Well Works Hancock
date well completed firm name county well located

LANDOWNER: R. W. Boebel
1608 Internatl. Trade Mart
New Orleans, La.
(mailing address)

WELL LOCATION:
sec. 27 T. 8 N. R. 15 E. S. 5 W.
6 miles W of Bay St.
(distance) (direction) of (nearest town)

WELL PURPOSE: home
(home, irrigation, municipal, industrial)

WELL COMPLETION DATA:
(1) diameter (inches) 4"
(2) total depth (feet) 730'
(3) static water level (feet) 15' below above top of ground.
(4) casing steel, 715'
(material) (depth)
4" if telescope see back.
(size)
(5) screen 15', 715'
(length) (depth to top)
4" stainless steel
(size) (material)
(6) pump none
(HP) (yield gpm)
(type power)
(7) electric log no
(yes or no)
(organization running log)
(8) how well bottom plugged B.P. Valve

description of formations encountered	depth	
	from	to
Clay	0	12
Sand	12	70
Clay	70	91
Sand	91	206
Clay	206	247
Sand & clay streaks	247	340
Clay	340	628
Sand	628	730


CODED

DRILLERS REMARKS:

RECEIVED
OCT 31 1977
MISS. BD. OF WATER COM.

If well telescopes please sketch and show depths.

GROUND LEVEL

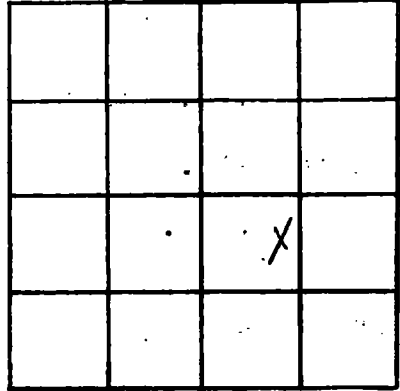

SECTION 27

Please indicate well location X.

ADDITIONAL INFORMATION

If more than one screen, show locations of each on sketch.