

Hancock
 J-29
 4-28-80

MISSISSIPPI
 BOARD OF WATER COMMISSIONERS
 416 North State Street
 Jackson, Mississippi 39201

CODED

WATER WELL DRILLERS LOG

4-28-80 Griner Drilling Hancock
 date well completed firm name county well located

LANDOWNER:
 Hunt Energy Corp.
 P.O. Box 4096
 Houma, La.
 (mailing address)

description of formations encountered	from to	
	from	to
Sand, pea gravel	0	126
Gravel and sand	126	189
Clay, sand, clay	189	315

WELL LOCATION: 1659' N E 190' W
 No. 1 Crosby 22-8 N R 15 E of Kiln
 5 miles South of Kiln
 (distance) (direction) (nearest town)

WELL PURPOSE: oil field supply
 (home, irrigation, municipal, industrial)


- WELL COMPLETION DATA:
- (1) diameter (inches) 4"
 - (2) total depth (feet) 315'
 - (3) static water level (feet) 30' ^{below} _{above} top of ground.
 - (4) casing Steel 189'
 (material) (depth)
 4" If telescope see back.
 (size)
 - (5) screen 42' 137'
 (length) (depth to top)
 4" perforated
 (size) (material)
 - (6) pump - 100
 (HP) (yield gpm)
 AC
 (type power)
 - (7) electric log -
 (yes or no)
 (organization running log)
 - (8) how well bottom plugged peel orange

DRILLERS REMARKS:

DEPT. OF NATURAL RESOURCES
 BUREAU OF LAND & WATER RESOURCES
 MAY 2 - 1980
 RECEIVED

If well telescopes please sketch and show depths.

GROUND LEVEL

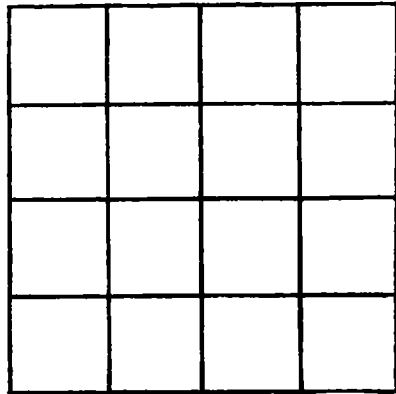

SECTION _____

Please indicate well location X.

ADDITIONAL INFORMATION

Lined area for providing additional information, consisting of approximately 20 horizontal lines.

If more than one screen, show locations of each on sketch.