

MISSISSIPPI DEPARTMENT OF NATURAL RESOURCES

Bureau of Land and Water Resources


Southport Mall

P.O. Box 10631

Jackson, Mississippi 39209

WATER WELL DRILLERS LOG

Griner Drilling Service, Inc

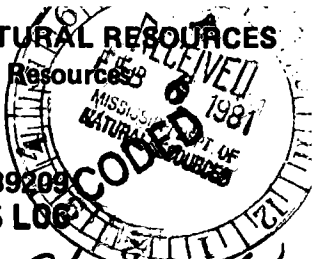


HANCOCK
J 30
1-28-81

date well completed *1-28-81* firm name *HANCOCK* county well located

LANDOWNER:	description of formations encountered	from	to
<i>Sun Texas</i> <i>1700 One Main Place</i> <i>Dallas, Texas 75250</i> (mailing address)	<i>Chalk, sand</i>	<i>0</i>	<i>21</i>
WELL LOCATION: <i>1200'S + 1200'W</i> <i>No 2 m. S of 28 T. 8 N. R. 15 E of Zongauling</i> <i>3 miles NE of Kiln</i> (distance) (direction) (nearest town)	<i>streaked</i>	<i>21</i>	<i>63</i>
WELL PURPOSE: <i>oil field</i> (home, irrigation, municipal, industrial)	<i>streaked</i>	<i>63</i>	<i>126</i>
WELL COMPLETION DATA: (1) diameter (Inches) <i>4"</i>	<i>sand, pea gravel</i>	<i>126</i>	<i>210</i>
(2) total depth (feet) <i>399'</i>	<i>streaked</i>	<i>210</i>	<i>252</i>
(3) static water level (feet) <i>50'</i> (below top of ground)	<i>sand</i>	<i>252</i>	<i>273</i>
(4) casing <i>steel 399'</i> (material) (depth) <i>4"</i> (size) If telescope see back.	<i>chalk</i>	<i>273</i>	<i>315</i>
(5) screen <i>42'</i> , <i>357'</i> (length) (depth to top) <i>4"</i> <i>perforated</i> (size) (material)	<i>streaked</i>	<i>315</i>	<i>357</i>
(6) pump <i>—</i> , <i>90</i> (HP) (yield gpm) <i>ac</i> (type power)	<i>sand</i>	<i>357</i>	<i>399</i>
(7) electric log <i>—</i> (yes or no) <i>—</i> (organization running log)			
(8) how well bottom plugged <i>orange peel</i>			
DRILLERS REMARKS:			

If well telescopes please sketch and show depths.

GROUND LEVEL

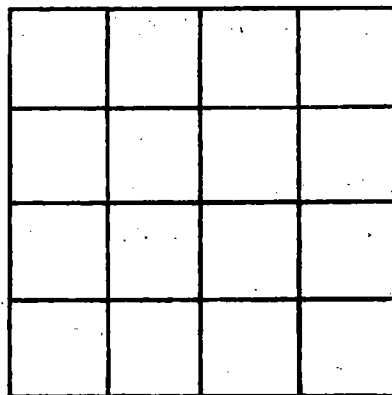

SECTION _____

Please indicate well location X.

ADDITIONAL INFORMATION

If more than one screen, show locations of each on sketch.