

MISSISSIPPI DEPARTMENT OF NATURAL RESOURCES

Bureau of Land and Water Resources

Southport Mall

P.O. Box 10631

Jackson, Mississippi 39209

WATER WELL DRILLERS LOG

CODED

Griner Drilling Service, Inc.

Hancock

HANCOCK  
J 32  
8/11/84

8-11-84  
date well completed

firm name

county well located

LANDOWNER:	description of formations encountered	from	to
Marshall R. Young 750 West 5th Street Fort Worth, Texas 76102 (mailing address)	sand, pea gravel	0	168
WELL LOCATION: 500'S + 500'W of No. sec. 36 T. 8 N R. 15 E NE 1/4 of 36-2A CUB NEKOR R. to CUB Waveland Field John (distance) miles (direction) of (nearest town)	sand, pea gravel	168	210
WELL PURPOSE: oilfield supply (home, irrigation, municipal, industrial)			
WELL COMPLETION DATA:			
(1) diameter (inches) 4"			
(2) total depth (feet) 210'			
(3) static water level (feet) 20' below top of ground			
(4) casing steel 210' (material), (depth) 4" (size) if telescope see back.			
(5) screen 42' (length), 168' (depth to top) 4" (size), perforated (material)			
(6) pump (HP) 90 (yield gpm) AC (type power)			
(7) electric log (yes or no) (organization running log)			
(8) how well bottom plugged Orange peel			
DRILLERS REMARKS:			

CODED


DEPT. OF NATURAL RESOURCES  
BUREAU OF LAND & WATER RESOURCES

SEP - 4 1984

RECEIVED

If well telescopes please sketch and show depths.

GROUND LEVEL

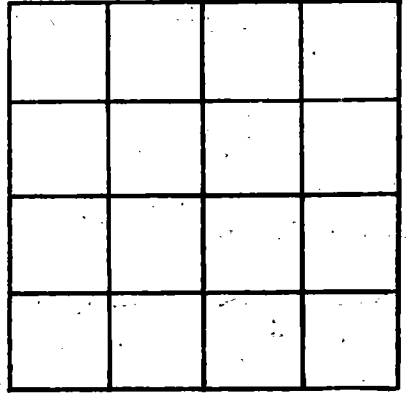

SECTION \_\_\_\_\_

Please indicate well location X.

ADDITIONAL INFORMATION

If more than one screen, show locations of each on sketch.